

2423

AUG 22 1995

LAND CORNER RECORDATION CERTIFICATE
Filing Requirement of Act 74, Mich. P.A. 1970

For corners in
Kalamazoo
(County)

COMMISSION

Located In:

Corner Code #/

Ross Township

1. Public Land Survey

T 1 S 9 W

E-3

T _____ R _____

T _____ R _____

T _____ R _____

T _____ R _____

2. Property Controlling in Section

S _____ T _____ R _____

S _____ T _____ R _____

3. Miscellaneous Property in Sec.

S _____ T _____ R _____

S _____ T _____ R _____

4. Lot No. _____, Recorded Plat _____

5. Private Claims _____

STATE OF MICHIGAN
 COUNTY OF KALAMAZOO
 RECEIVED FOR RECORD

95 JUN 6 AM 9 06


CLERK - REGISTER

Register of Deeds Stamp & File Number

I, Robert E. Snell, in a field survey on September 9, 19 94, do hereby certify that under requirements of P.A. 74, Michigan P.A. of 1970, the corner points mentioned in lines 1 and 2 above were in conformance with regulations and rules therefore as required in the current manual of survey instructions of the United States Department of the Interior, Bureau of Land Management or by a decree of a Court of Law and/or that the corner points mentioned in lines 3, 4 and 5 above were in conformance with the rules of the Michigan Board of Land Surveyors or by a Decree of a Court of Law; established, re-established, monumented, re-monumented, recovered, found as expressed below:

NOTE: Not more than 4 corners, all in the same town and range, may be recorded on this certificate.

LIBER **1 1301**

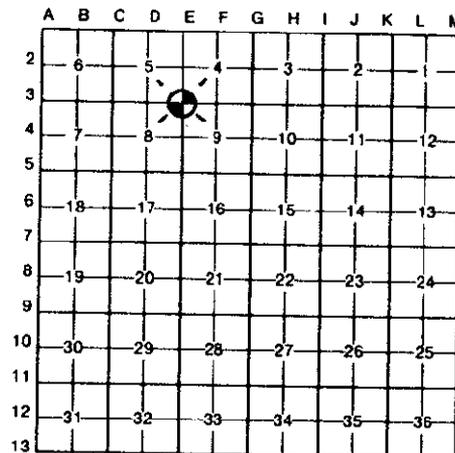

A. Description of original monument and accessories and/or subsequent restoration:

1826: United States Government Survey; Set Post, Corner to Sections 4, 5, 8 and 9.

Wh. Oak 5" South 56° West 126 Lks
 Y. Oak 18" North 73° East 250 Lks

1883: F. Hodgman, County Surveyor; Ran South 58 3/4° West, 80 Lks from stump of Y. Oak bearing tree by Pratt, to stake. Bored 3'. Put in brick and stone in bottom and 2' earthen post over.

Red Oak 18" North 10° East 148 Lks
 Wh. Oak 12" South 82 1/2° East 104 1/2 Lks

B. Description of corner evidence found and/or method applied in restoring or reestablishing corner:

1941: Wilkins & Wheaton Engineering Company; Found tile 1' below surface. Placed iron over.

Oak 24" North 70° West 91.45'
 Maple 6" North 20° West 105.69'
 Hickory 8" North 20° East 114.15'
 Oak 24" North 80° East 192.68'

1994: Found 1/2" iron in monument box, tile 1' below in Centerline of 40th Street.

RATIFIED
BY KALAMAZOO COUNTY
REMONUMENTATION
PEER GROUP
 12-15-94

[Signature]

C. Description of monument for corner and accessories established to perpetuate locating the position of the corner:

E-3 Southwest Corner Section 4, T. 1 S., R. 9 W., ratified by the Kalamazoo County Remonumentation Program Peer Group on December 15, 1994. Found a 3" round tile with "X" on top, 20" below surface, as called for in 1883 remonumentation survey by F. Hodgman and is accepted as a careful and faithful perpetuation of the position of the original corner. Placed 20" Harrison monument and monument box over tile.

Exist. Nail/Tab in South Side 30" Oak North 84° East 126.92'
 Exist. Nail/Tab in North Side 30" Oak South 70° West 116.61'
 Exist. Nail/Tab in South Side 36" Oak North 64° West 92.59'
 PK Nail in East Side Power Pole North 24° West 76.48'

Signed by *Robert E. Snell*
 Surveyor's Michigan License No. 9734

Date 6-5-95