

APR 01 1996

COMMISSION

LAND CORNER RECORDATION CERTIFICATE
Filing Requirement of Act 74, Mich. P.A. 1970

STATE OF MICHIGAN
COUNTY OF KALAMAZOO
RECEIVED FOR RECORD

'96 JAN 23 PM 3 50

For corners in
Kalamazoo
(County)
Richland Twp.

Located in:

Corner Code #

- | | | | | | |
|---|---|------|---|-------|------|
| 1. Public Land Survey | T | 1 S. | R | 10 W. | G-11 |
| | T | | R | | |
| | T | | R | | |
| | T | | R | | |
| 2. Property Controlling
in Section | S | | T | R | |
| | S | | T | R | |
| 3. Miscellaneous
Property in Section | S | | T | R | |
| | S | | T | R | |

James P. Young
CLERK-REGISTER

LIBER 1 1435

Register of Deeds Stamp & File Number

4. Lot No. _____, Recorded Plat _____
5. Private Claims _____

I, Robert E. Snell, in a field survey on November 22, 1995, do hereby certify that under requirements of P.A. 74, Michigan P.A. of 1970, the corner points mentioned in lines 1 and 2 above were in conformance with regulations and rules therefore as required in the current manual of survey instructions of the United States Department of the Interior, Bureau of Land Management or by a decree of a Court of Law and/or that the corner points mentioned in lines 3, 4 and 5 above were in conformance with the rules of the Michigan Board of Professional Surveyors or by a Decree of a Court of Law; established, re-established, monumented, re-monumented, recovered, found as expressed below:


NOTE: Not more than 4 corners, all in the same town and range, may be recorded on this certificate.

A. Description of original monument and accessories and/or subsequent restoration:

- 1826: United States Government Surveyors; Black Oak 18" for 1/4 Section post.
1887: F. Hodgman, County Surveyor; Set post in open field N. 41 1/2° E. 120 lks. from bearing tree of resurvey. Y. Oak 18" N. 09° W. 381 lks.

B. Description of corner evidence found and/or method applied in restoring or reestablishing corner:

- 1918: Found tile.
1960: Found tile. 13" Oak N. 09° E. 252.37'
37" Oak N. 21° W. 265.60'
24" Hickory S. 45° W. 79.83'
1995: Found tile down about 1'.

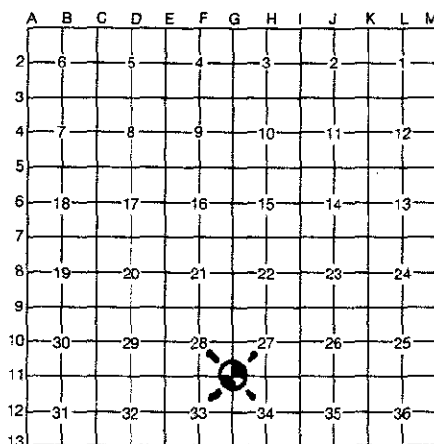

RATIFIED
BY KALAMAZOO COUNTY
REMONUMENTATION
PEER GROUP
12-14-95

C. Description of monument for corner and accessories established to perpetuate locating the position of the corner:

G-11: South 1/4 post Section 28, T. 1 S., R. 10 W., Ratified by the Kalamazoo County Remonumentation Program Peer Group on December 14, 1995 and is accepted as a careful and faithful perpetuation of the position of the original corner. Found plat monument (4" dia. concrete x 36" with 1/2" rerod in center, placed circa 1966 for the Upjohn Company). Replaced plat monument with 30" Harrison Monument.

Center Line	Fence Post	North	75.0'
Center Line	18" Oak	N. 09° E.	252.37'
Center Line	40" Oak	N. 20° W.	265.60'
Center Line	24" Hickory	S. 45° W.	79.80'

Signed by

Robert E. Snell

Date

1-18-96

Surveyor's Michigan License No. 9734