Jimvey a ... DAUMENMATION

APR 0 1 1996

COMMISSION

KALAMAZOO COUNTY REMONUMENTATION COUNTY OF KALAMAZOO

LAND CORNER RECORDATION CERTIFICATE Filing Requirement of Act 74, Mich. P.A. 1970

STATE OF MICHIGAN RECEIVED FOR RECORD

(i.)

'95 NOV 17 AM 9 37

For corners in KALAMAZOO Located In: Corner Code ## R RICHLAND TOWNSHIP VEY CLERK - REGISTER REFERENCE MONUMENT TO MEANDER POST ON BASE LINE AT _ R . WEST SHORE OF LITTLE LONG LAKE Other #1 _R10W LIBER 2. Property Controlling R_ in Section T Miscellaneous Register of Deeds Stamp & File Number Property in Sec. ___ , Recorded Plat . 5. Private Claims _

I, BRIAN REYNOLDS , in a field survey on OCTOBER 24 95 do hereby certify that under requirements of P.A. 74, Michigan P.A. of 1970, the corner points mentioned in lines 1 and 2 above were in conformance with regulations and rules therefore as required in the current manual of survey instructions of the United States Department of the Interior, Bureau of Land Management or by a decree of a Court of Law and/or that the corner points mentioned in lines 3, 4 and 5 above were in conformance with the rules of the Michigan Board of Land Surveyors or by a Decree of a Court of Law; established, re-established, monumented, re-monumented, recovered, found as expressed below:

NOTE: Not more than 4 corners, all in the same town and range, may be recorded on this certificate.

10 11 12

- A. Description of original monument and accessories and/or subsequent restoration:
- 1. MEANDER CORNER ON WEST SIDE OF LITTLE LONG LAKE WAS ESTABLISHED BY GENERAL LAND OFFICE DEPUTY SURVEYOR JOHN MULLETT IN DECEMBER, 1825. THE NOTES INDICATE THAT THE CORNER WAS 37.16 CHAINS EAST OF J-13, THE NEAREST STANDARD CORNER NOT IN A LAKE. MEANDER POST NOTED AS "LEAVE ELM 8 S22 1/2W 40." LAKE SETPOST ASPEN 10 S24E 29
- RESURVEY OF PRAIRIEVILLE TOWNSHIP BY BARRY COUNTY DEPUTY SURVEYOR JOHN Q. CRESSY IN OCTOBER, 1884, NOTES INDICATE THAT FROM J-13 TO THE WEST BANK OF LITTLE LONG LAKE IS 30.12 CHAINS. CRESSY'S NOTES INDICATE THAT THE SOUTHWEST CORNER OF SECTION 36 IS "IN LAKE." CRESSY DID NOT SET A POST ON THE SHORE, AND NO WITNESS WERE NOTED.
- B. Description of corner evidence found and/or method applied in restoring or reestablishing corner:

NO DIRECT EVIDENCE REMAINS OF THE GENERAL LAND OFFICE SURVEY OR THE CRESSY RESURVEY BETWEEN J-13 AND LITTLE LONG LAKE. THERE ARE SEVERAL HUNDRED FEET OF MARSH BETWEEN THE OPEN WATERS OF LITTLE LONG LAKE AND THE HIGH GROUND TO THE WEST; THIS WOULD ACCOUNT FOR THE DIFFERENCE IN DISTANCE CITED BY CRESSY AND MULLETT. AFTER RESTORING THE BASE LINE BETWEEN LITTLE LONG LAKE AND GULL LAKE, AND TRAVERSING TO J-13 T1N R10W AND J-1 T1S R10W, DETERMINED THAT BEST METHOD OF RESTORATION OF MEANDER CORNER WOULD BE TO PLACE IT ON LINE BETWEEN RESTORED POINT ON BASE LINE ON EAST SIDE OF LONG LAKE AND J-13, AS CLOSE AS IS PRACTICAL TO THE OPEN WATERS OF LITTLE LONG LAKE. SET HARRISON MONUMENT ON SMALL HIGH SPOT NEAR OPEN WATER. TWO PARALLEL EAST-WEST FENCES INTERSECT THE LAKE; THE OLDER FENCE IS 8' NORTH OF THE MONUMENT, THE NEWER FENCE IS 14.5' NORTH OF THE MONUMENT. RATIFIED

SEE REVERSE OF THIS FORM FOR GRAPHICAL REPRESENTATION

BY KALAMAZOO COUNTY REMONUMENTATION

BRIAN

REYNOLDS

LAND SURVEYOR

NO.

31602

C. Description of monument for corner and accessories established to perpetuate locating the position of the corner. OF MICHIG

SET STANDARD KALAMAZOO COUNTY REMONUMENTATION MONUMENT (HARRISON) WITNESSES: N82°F 13.67


NAIL AND TAG IN N SIDE OF 5" ELM NAIL AND TAG IN S SIDE OF 8" ELM S66°E 12.27 NAIL AND TAG IN E SIDE OF 10" ELM 15.00 S24°F NAIL AND TAG IN SE SIDE OF 12" ELM S25°W 29.53 EAST SHORE OF LITTLE LONG LAKE **EAST** 19.5'+/-15.5'+/-EAST SHORE OF LITTLE LONG LAKE **NORTH**

Signed by

Surveyor's Michigan License No.

FORM APPROVED BY MICHIGAN STATE BOARD OF LAND SURVEYORS, JAN. 28, 1971 REVISED MAY 14, 1975

--

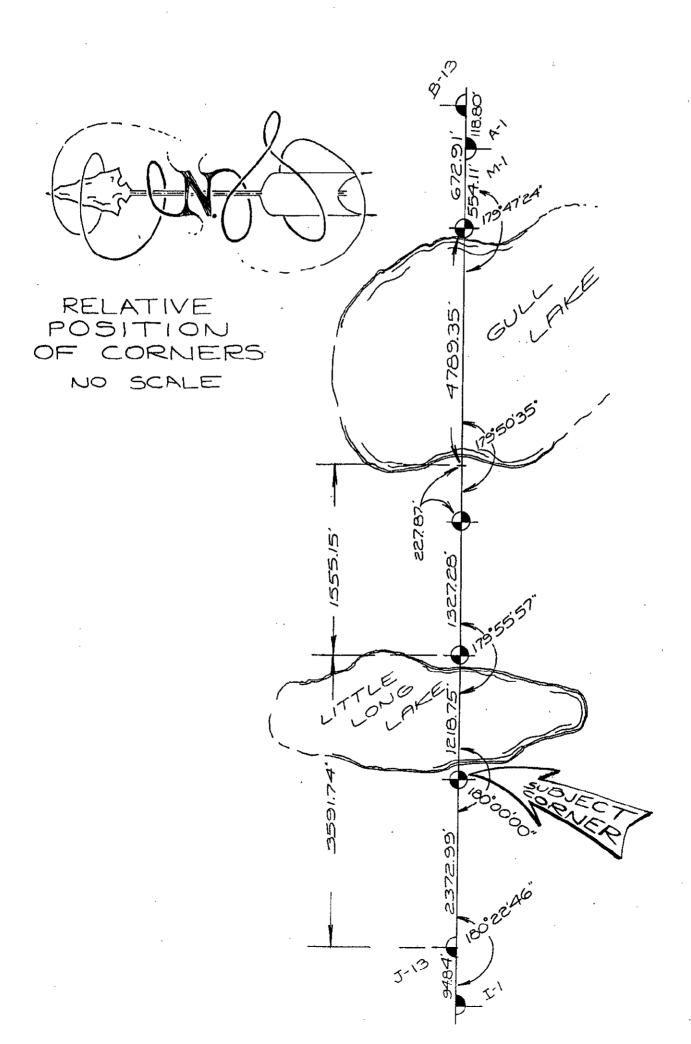

E.

£ 92