

SURVEY &  
REMONUMENTATION

JUL 23 1997

COMMISSION

LAND CORNER RECORDATION CERTIFICATE

Filing Requirement of Act 74, Mich. P.A. 1970

For corners in Cooper Township  
Kalamazoo  
(County)

Located In:

Corner Code #

- |   |   |     |   |      |      |
|---|---|-----|---|------|------|
| 1. Public Land Survey                   | T | 1S. | R | 11W. | B-13 |
|   | T |     | R |      |      |
|   | T |     | R |      |      |
|   | T |     | R |      |      |
| 2. Property Controlling<br>in Section   | S | T   | R |      |      |
|   | S | T   | R |      |      |
| 3. Miscellaneous<br>Property in Section | S | T   | R |      |      |
|   | S | T   | R |      |      |

4. Lot No. \_\_\_\_\_, Recorded Plat \_\_\_\_\_
5. Private Claims \_\_\_\_\_

I, Allen H. McMachen, in a field survey on March 21, 1997, do hereby certify that under requirements of P.A. 74, Michigan P.A. of 1970, the corner points mentioned in lines 1 and 2 above were in conformance with regulations and rules therefore as required in the current manual of survey instructions of the United States Department of the Interior, Bureau of Land Management or by a decree of a Court of Law and/or that the corner points mentioned in lines 3, 4 and 5 above were in conformance with the rules of the Michigan Board of Professional Surveyors or by a Decree of a Court of Law; established, re-established, monumented, re-monumented, recovered, found as expressed below:

**NOTE:** Not more than 4 corners, all in the same town and range, may be recorded on this certificate.

A. Description of original monument and accessories and/or subsequent restoration:

1827 - John Mullet, D.S., Set quarter Section post, Cherry 7" N. 55° E. 53 lks., Lynn 7" N. 34° W. 19 lks.  
1904 - E. Strong, C.S., "Stone gone, U.S. gone - dug and found good deep U.S. stake hole, Stake I set in same hole and stone above, Drilled. Fence North correct. Fence West is 1' North of line.

1956 - Consumers Power Company, Found drilled stone, 20" Ash N. 86° W. 43.65', 8" Walnut S. 46° W. 50.47', 26" Basswood N. 37° W. 7.35', 2.4' South of East and West fence, North quarter post, Section 6, 5/8" iron rod 73.35' East.  
1976 - Ingersoll, Watson & McMachen, Inc., Found drilled stone 2.5' South of fence, 10" Sass. S. 35° E. 14.94', 10" Sass. S. 45° W. 16.03'

B. Description of corner evidence found and/or method applied in restoring or reestablishing corner:

Found drilled stone per 1976 witnesses. Measured East 73.2' to fence line South, continued East 59' to concrete monument (Northwest corner, Lot 29, Plat of "Northview Hills" L. 27, Pg. 40).

RATIFIED  
BY KALAMAZOO COUNTY  
REMONUMENTATION  
PEER GROUP  
4-16-1997

C. Description of monument for corner and accessories established to perpetuate locating the position of the corner:

Found stone is accepted as a careful and faithful perpetuation of the position of the original corner. Replaced found stone with a Harrison monument and placed monument box over, Accessories:


- "PK" Nail in Northeasterly side 30" Oak N. 20° W. 7.8'  
"PK" Nail in 18" Sassafras S. 75° E. 15.3'  
"PK" Nail in N.E. side 15" Sassafras S. 35° E. 14.6'  
"PK" Nail in N.W. side 18" Cherry S. 50° W. 22.2'

Signed by

Allen H. McMachen

Surveyor's Michigan License No.

16935

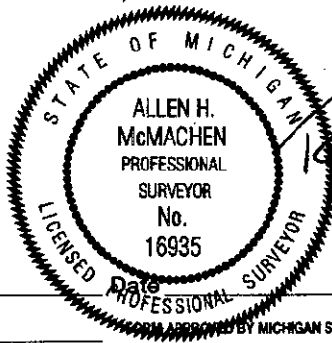

5/15/97

STATE OF MICHIGAN  
COUNTY OF KALAMAZOO  
RECEIVED FOR RECORD

'97 MAY 16 PM 3 49

Timothy Brown  
CLERK - REGISTER

LIBER 2 PAGE 128

Register of Deeds Stamp & File Number

	A	B	C	D	E	F	G	H	I	J	K	L	M
2	6		5		4		3		2		1		
3													
4	7		8		9		10		11		12		
5													
6	18		17		16		15		14		13		
7													
8	19		20		21		22		23		24		
9													
10	30		29		28		27		26		25		
11													
12	31		32		33		34		35		36		
13													