

APR 27 1995

COMMISSION

LAND CORNER RECORDATION CERTIFICATE
Filing Requirement of Act 74, Mich. P.A. 1970

For corners in KALAMAZOO TWP.

KALAMAZOO
(County)

Located In:

Corner Code ~~##~~

1. Public Land Survey

T 2 S R 11 W

C-2

T _____ R _____

T _____ R _____

4. Lot No. _____, Recorded Plat

5. Private Claims

I, Allen H. McMachen, in a field survey on Febuary 16, 1994

do hereby certify that under requirements of P.A. 74, Michigan P.A. of 1970, the corner points mentioned in lines 1 and 2 above were in conformance with regulations and rules therefore as required in the current manual of survey instructions of the United States Department of the Interior, Bureau of Land Management or by a decree of a Court of Law and/or that the corner points mentioned in lines 3, 4 and 5 above were in conformance with the rules of the Michigan Board of Land Surveyors or by a Decree of a Court of Law; established, re-established, monumented, re-monumented, recovered, found as expressed below:

NOTE: Not more than 4 corners, all in the same town and range, may be recorded on this certificate.


A. Description of original monument and accessories and/or subsequent restoration:

1880's - F. Hodgeman C.S. placed Clay Tile post during official Township Remonumentation.

B. Description of corner evidence found and/or method applied in restoring or reestablishing corner:

Found Clay Tile 1.5' below road surface.

RATIFIED
BY KALAMAZOO COUNTY
REMONUMENTATION
PEER GROUP
3-17-94

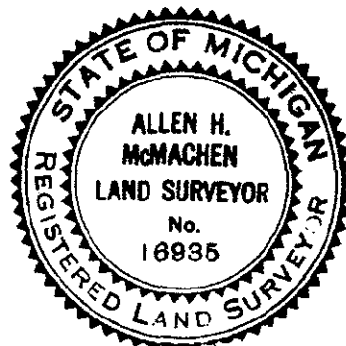

C. Description of monument for corner and accessories established to perpetuate locating the position of the corner:

Found Clay Tile is accepted as a careful and faithful perpetuation of original corner. Placed Harrison monument over existing Tile and placed monument box over.

Accessories:

Nail & Tab in S. side Utility Pole EAST 23.92'

Nail & Tab in E. side 26" Elm S. 18° W. 82.75'

Nail & Tab in S. side 14" Elm N. 80° W. 31.28'

Nail & Tab in E. side 16" Elm N. 34° W. 44.02'

1.0' West of center line road.

Signed by

Date _____

Surveyor's Michigan License No.