

# SURVEY & REMONUMENTATION

7-2 MAY 28 1997

COMMISSION

## LAND CORNER RECORDATION CERTIFICATE Filing Requirement of Act 74, Mich. P.A. 1970

LIBER 2 PAGE 105

For corners in

Kalamazoo Located in: Corner Code #  
(County)  
Oshtemo Twp.  
1. Public Land Survey T 2S R 12W B8  
T R  
T R  
T R  
2. Property Controlling S T R  
in Section S T R  
3. Miscellaneous S T R  
Property in Sec. S T R

STATE OF MICHIGAN  
COUNTY OF KALAMAZOO  
RECEIVED FOR RECORD  
96 JUN 31 PM 3 21  
CLERK-REGISTER  
Register of Deeds Stamp & File Number

4. Lot No. \_\_\_\_\_, Recorded Plat \_\_\_\_\_  
5. Private Claims \_\_\_\_\_


I, Gary D. Hahn, in a field survey on May 6, 1996 do hereby state that under requirements of P.A. 74, Michigan P.A. of 1970, the corner points mentioned in lines 1 and 2 above were in conformance with regulations and rules therefore as required in the current manual of survey instructions of the United States Department of the Interior, Bureau of Land Management or by a decree of a Court of Law and /or that the corner points mentioned in lines 3, 4 and 5 above were in conformance with the rules of the Michigan Board of Land Surveyors or by a Decree of a Court of Law; established, re-established, monumented, recovered, found as expressed below:

NOTE: Not more than 2 corners, all in the same town and range, may be recorded on this certificate.

	A	B	C	D	E	F	G	H	I	J	K	L	M
1													
2		6		5		4		3		2		1	
3													
4		7		8		9		10		11		12	
5													
6		18		17		16		15		14		13	
7													
8				20		21		22		23		24	
9													
10		30		29		28		27		26		25	
11													
12		31		32		33		34		35		36	
13													

A. Description of original monument and accessories and/or subsequent restoration:

This corner not established during original G.L.O. survey.  
1871 F. Hodgman: At intersection of quarter lines, planted cedar stake and brick around and marked 14" W. Oak South 66 1/2 degrees West 186 1/2 12" W. Oak South 11 1/2 degrees West 183  
1892 E. Strong: Found brick corner of record.  
1973 Dennis Middleton, L.C.R.C. L.1,P. 243: Fnd. 3/8" iron in mon. box as called for in survey by Lark Winther.  
1976 Wenley Smith, L.C.R.C. L.1,P.676: Fnd. 1/4" rod in mon. box.  
Date? KCRC witness notes: SW. cor. upright church N.E. 94.0'  
W.O. 16" South 15 degrees West 133.0'  
W.O. 26" South 66 degrees West 121.8'

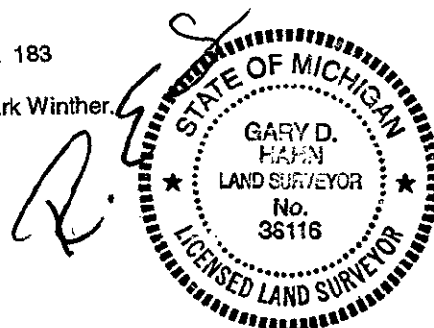

B. Description of corner evidence found and/or method applied in restoring or reestablishing corner:

Fnd. A 1/4" rebar in mon. box 4.5' +/- East of centerline of 1st Street and on centerline of "KL" Ave. Dug down and found a cedar stake surrounded by red clay brick 2' +/- below road surface. Stake was directly below 1/4" rebar.

RATIFIED  
BY KALAMAZOO COUNTY  
REMONUMENTATION  
PEER GROUP

6-20-1996

C. Description of monument for corner and accessories established to perpetuate locating the position of the corner:

B8, Center Section 19, Town 2 South, Range 12 West, ratified by Kalamazoo County Remonumentation Peer Group on June 20, 1996. Found Cedar stake believed to be same as set by F. Hodgman in 1871. This position not established by original government surveyors. The position of the Cedar stake is accepted as the best available evidence of the position of the corner. Set 20" Harrison Monument over Cedar stake in mon. box.  
Fnd. Nail in P.P. South 52 degrees East 54.99'  
Set P.K. nail in 36" Oak South 33 degrees West 50.20'  
Set P.K. nail in P.P. South 69 degrees West 91.02'  
Fnd. P.K. nail in P.P. North 54 degrees West 36.63'

Signed by Gary D. Hahn  
Surveyor's Michigan License No. 38116

Date 12/31/96