

SURVEY & REMONUMENTATION

AUG 22 1995

COMMISSION

LAND CORNER RECORDATION CERTIFICATE

Filing Requirement of Act 74, Mich. P.A. 1970

For corners in PAVILION TWP.

KALAMAZOO
(County)

Located In:

Corner Code #

1. Public Land Survey T 3 S R 10 W C-3
T R
T R
T R
2. Property Controlling S T R
in Section S T R
3. Miscellaneous S T R
Property in Section S T R
4. Lot No. , Recorded Plat
5. Private Claims

STATE OF MICHIGAN
COUNTY OF KALAMAZOO
RECEIVED FOR RECORD

'95 MAR 23 PM 4 09

James J. Jones
CLERK-REGISTER

1 PG 1277

LIBER

Register of Deeds Stamp & File Number

I, Allen H. McMachen field survey on January 11, 1995, do hereby certify that under requirements of P.A. 74, Michigan P.A. of 1970, the corner points mentioned in lines 1 and 2 above were in conformance with regulations and rules therefore as required in the current manual of survey instructions of the United States Department of the Interior, Bureau of Land Management or by a decree of a Court of Law and/or that the corner points mentioned in lines 3, 4 and 5 above were in conformance with the rules of the Michigan Board of Professional Surveyors or by a Decree of a Court of Law; established, re-established, monumented, re-monumented, recovered, found as expressed below:

NOTE: Not more than 4 corners, all in the same town and range, may be recorded on this certificate.

A. Description of original monument and accessories and/or subsequent restoration:


1827 - R. Clark, D.S., Set Post
Elm 9" S. 7° W. 160 lks.
Maple 6" S. 28° E. 212 lks.

1888 - F. Hodgeman, C.S., Set Post N. 7° E. 160 lks.
from Elm bearing tree standing Oak 12" N. 60° E. 122 lks.

B. Description of corner evidence found and/or method applied in restoring or reestablishing corner:

Found Clay Tile in monument box.

RATIFIED
BY KALAMAZOO COUNTY
REMONUMENTATION
PEER GROUP
2/16/95

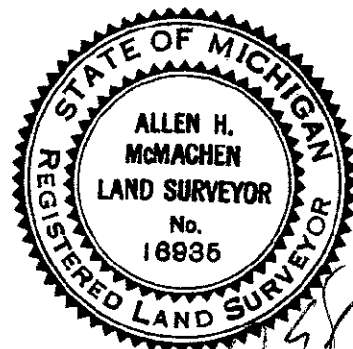

C. Description of monument for corner and accessories established to perpetuate locating the position of the corner:

Found Clay Tile is accepted as a careful and faithful perpetuation of the position of the original corner. Placed standard sleeve over existing Clay Tile and raised monument box to surface. Accessories:

Nail & Tab in W. Face 30" Maple S. 10° W. 20.56'
Nail & Tab in S.E. Face 8" Maple S. 50° W. 25.47'
Nail & Tab in S.E. Face 8" Twin Maple S. 70° W. 44.51'
Nail & Tab in S.W. Face 10" Twin Maple N. 50° W. 42.80'

Signed by

Allen H. McMachen
16935

Date

3/22/95

Surveyor's Michigan License No.