

SURVEY & REMONUMENTATION

FEB 18 1994

COMMISSION

KALAMAZOO COUNTY REMONUMENTATION LAND CORNER RECORDATION CERTIFICATE

Filing Requirement of Act 74, Mich. P.A. 1970

STATE OF MICHIGAN
COUNTY OF KALAMAZOO
RECEIVED FOR RECORD

'93 NOV 11 AM 8 54

James E. Gump
CLERK-REGISTER

For corners in

Kalamazoo
(County)

Located In:

Corner Code #

1. Public Land Survey

T 3S R 12W

D-13

T R

S 1/4 Cor.

T R

Sec. 32

T R

Texas Twp.

2. Property Controlling
in Section

S T R

S T R

3. Miscellaneous
Property in Sec.

S T R

S T R

LIBER

1 PG 1014

Register of Deeds Stamp & File Number

4. Lot No. , Recorded Plat

5. Private Claims

Thomas W.

Chettleburgh

I, Thomas W. Chettleburgh, in a field survey on October 15, 1993

do hereby certify that under requirements of P.A. 74, Michigan P.A. of 1970, the corner points mentioned in lines 1 and 2 above were in conformance with regulations and rules therefore as required in the current manual of survey instructions of the United States Department of the Interior, Bureau of Land Management or by a decree of a Court of Law and/or that the corner points mentioned in lines 3, 4 and 5 above were in conformance with the rules of the Michigan Board of Land Surveyors or by a Decree of a Court of Law; established, re-established, monumented, re-monumented, recovered, found, as expressed below:

NOTE: Not more than 4 corners, all in the same town and range, may be recorded on this certificate.

A. Description of original monument and accessories and/or subsequent restoration:

Strong 1901, Found post, set stone

B. Description of corner evidence found and/or method applied in restoring or reestablishing corner:

Found stone with chiseled "+"
on old N-S fence line
also a second N-S fence line East 5'
N-S creek East 17'

Replaced stone with 4" X 30" Harrison Monument

**RATIFIED
BY KALAMAZOO COUNTY
REMONUMENTATION
PEER GROUP**

C. Description of monument for corner and accessories established to perpetuate locating the position of the corner:

4" X 30" Harrison Monument

N1/4 Cor. Sec. 5, T4S, R12W, (4" Harrison Monument) West 60.72'


Spike NW side 18" Birch N64°E 24.15'

Spike NE side 12" Oak S61°E 41.51'

Spike E side 34' Oak S9°W 41.11'

Spike S side 36" Oak S73°W 27.30'

Spike E side 15" Maple N12°W 40.73'

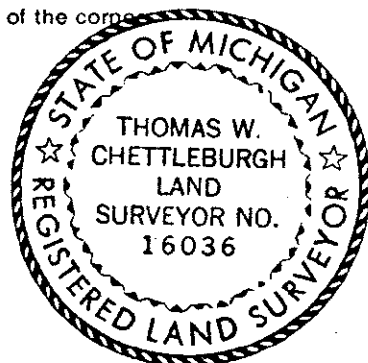

Signed by

Thomas W. Chettleburgh

Date

November 8, 1993

Surveyor's Michigan License No.

16036