

SURVEY & REMONUMENTATION

FEB 26 1998

LIBER 2 PAGE 221

SECTION

LAND CORNER RECORDATION CERTIFICATE
Filing Requirement of Act 74, Mich. P.A. 1970

For corners in Wakeshma Township

Kalamazoo (County)	Located In:	Corner Code #
1. Public Land Survey	T4S R9W	F-03
	T R	
	T R	
	T R	
2. Property Controlling in Section	S T R	
	S T R	
3. Miscellaneous Property in Sec.	S T R	
	S T R	

STATE OF MICHIGAN
COUNTY OF KALAMAZOO
RECEIVED FOR RECORD
97 OCT 22 AM 10 41
CLERK - REGISTER


Register of Deeds Stamp & File Number

4. Lot No. _____, Recorded Plat _____
5. Private Claims _____

I, Robert E. Snell, in a field survey on July 24, 1997 do hereby state that under requirements of P.A. 74, Michigan P.A. of 1970, the corner points mentioned in lines 1 and 2 above were in conformance with regulations and rules therefore as required in the current manual of survey instructions of the United States Department of the Interior, Bureau of Land Management or by a decree of a Court of Law and/or that the corner points mentioned in lines 3, 4 and 5 above were in conformance with the rules of the Michigan Board of Land Surveyors or by a Decree of a Court of Law; established, re-established, monumented, recovered, found as expressed below:

NOTE: Not more than 2 corners, all in the same town and range, may be recorded on this certificate.

RATIFIED
BY KALAMAZOO COUNTY
REMONUMENTATION
PEER GROUP 8-21-1997

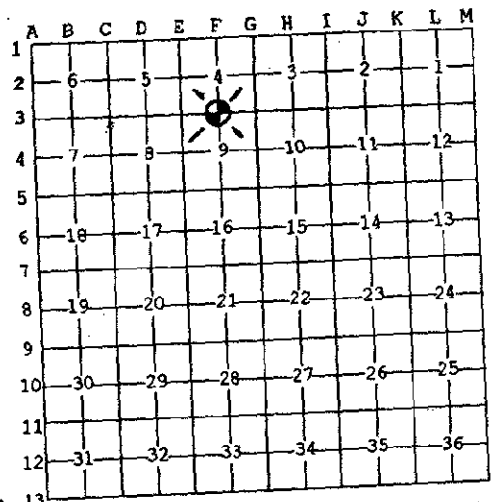

A. Description of original monument and accessories and/or subsequent restoration:
1826: United States Government Surveyors; set 1/4 section post.

Elm 20" N. 23° E. 32 1/2 lks.
Birch 6" N. 88° W. 24 1/2 lks.

1884: F. Hodgman, County Surveyor; "7(South 1/4 Section 4) found stake in crossway and stump of Birch bearing tree S. 38° E., 68 lks. Put in new stake with crockery around."

1911: E. Strong, County Surveyor; "Dug long cut out of the crossway. I found stake and crockery (jug) around. Left the stake and crockery; set large stone above crockery and stake." Double Elm 7" S. 02° W. 59 lks.
Corner Post North 42 lks.

B. Description of corner evidence found and/or method applied in restoring or reestablishing corner:

1976: Wilkins & Wheaton Engineering Co., R.E. Snell RLS #9734; L.C.R.C. L-1, P-672. Found stone. South End Culvert S. 50° W. 20.0'
North End Culvert N. 35° W. 25.3'
Fence Post S. 05° E. 31.0'

1982: A. McMachen #16935; L.C.R.C., L-1, P 842. Found stone & crockery, set concrete monument in monument box. Oak 10", S. 50° E., 25.30'; Sycamore 12", N. 30° W., 67.61'; Ash 8", N. 01° W., 44.45'.

1996: Found plat monument at surface with monument box over (down 3"+). Found crockery and small stones around monument.

C. Description of monument for corner and accessories established to perpetuate locating the position of the corner:

F-03: South 1/4 post, Section 4, T. 3 S., R. 9 W., ratified by the Kalamazoo County Remonumentation Program Peer Group on August 21, 1997 and is accepted as a careful and faithful perpetuation of the position of the original corner. Found plat monument as set in 1982 to replace stone set by E. Strong, County Surveyor in a 1911 survey. Removed monument and placed iron rod and concrete pieces around in bottom of hole. Placed 20" Harrison Monument and new monument box over.

P.K. nail in West side	15" Elm	North	44.62'
P.K. nail in East side	18" Oak	S. 40° E.	25.66'
P.K. nail in East side	18" Sycamore	N. 30° W.	67.51'
P.K. nail in East side	6" Boxelder	S. 12° W.	18.73'

Signed by

Surveyor's Michigan License No. 9734

Date

Oct. 22, 1997