

FEB 08 1999

LIBER

2 PAGE 408

SECTION

LAND CORNER RECORDATION CERTIFICATE
Filing Requirement of Act 74, Mich. P.A. 1970

For corners in

Kalamazoo

(County)

Wakeshma Twp.

Located In:

Corner Code#

1. Public Land Survey

T 4S R 9W

G7

2. Property Controlling in Section

S

T

R

3. Miscellaneous

S

T

R

Property in Sec.

S

T

R

4. Lot No. , Recorded Plat

5. Private Claims

CLERK - REGISTER

98 DEC 23 AM 3 05

STATE OF MICHIGAN
COUNTY OF KALAMAZOO
RECEIVED FOR RECORD

Register of Deeds Stamp & File Number

	A	B	C	D	E	F	G	H	I	J	K	L	M
1													
2	6		5		4		3		2		1		
3													
4	7		8		9		10		11		12		
5													
6	18		17		16		15		14		13		
7													
8	19		20		21		22		23		24		
9													
10	30		29		28		27		26		25		
11													
12	31		32		33		34		35		36		
13													

I, Gary D. Hahn, in a field survey on October 29, 1998 do hereby state that under requirements of P.A. 74, Michigan P.A. of 1970, the corner points mentioned in lines 1 and 2 above were in conformance with regulations and rules therefore as required in the current manual of survey instructions of the United States Department of the Interior, Bureau of Land Management or by a decree of a Court of Law and/or that the corner points mentioned in lines 3, 4 and 5 above were in conformance with the rules of the Michigan Board of Land Surveyors or by a Decree of a Court of Law; established, re-established, monumented, recovered, found as expressed below:

NOTE: Not more than 2 corners, all in the same town and range, may be recorded on this certificate.

A. Description of original monument and accessories and/or subsequent restoration:

1826 - Established by U.S. Deputy Surveyor Robert Clark, Jr.
Beech 18" N 67 E 20 1/2 Lks. Beech 14" S 53 W 11 1/2 Lks.

1903 - E. Strong: "Corner sec. 15, 16, 21, 22 found stone drilled by nutting."

1976 - L.C.R.C. (L. 1 P. 781) Milton E. Dekeyser - 2" pipe with 1/2" iron inside in C.L. of road
N.W. lower corner of bldg. foundation S 45 E 68.00'
N.E. corner bldg. S 45 W 52.00'
Nail & cap in Utility pole N 65 W 49.90'

KCRC Witness Ties:

Fd. 11-2-48 Iron
N.E. Cor. Br. Bldg. S.W. 52.12'
N.W. Cor. Conc. Bldg. S.E. 69.12'
S.E. Cor. Twp. Hall N.W. 109.13'
S.E. Cor. Bank N.W. 51.63'
N.E. Cor. Br. Bldg. S.W. 52.33'
N.E. Cor. Conc. Bldg. S.E. 68.20'

B. Description of corner evidence found and/or method applied in restoring or reestablishing corner:

1998 - Original monument and accessories not recovered. Found 1/2" rod in 2" pipe. Removed. Found 12" dia. 18" long cylinder of concrete poured inside 12" clay pipe 0.83' south and 0.48' east of 1/2" rod. Found 14" x 24" flat topped stone with a 3/4" drill hole 3' ± below surface and covered by four 7" - 12" dia. round stones. Drill hole is near easterly side of flat top of stone. Drill hole is 0.04' north and 0.18' east of 1/2" rebar.

C. Description of monument for corner and accessories established to perpetuate locating the position of the corner:

G-7, Southeast Corner Section 16, Town 4 South, Range 9 West, ratified by Kalamazoo County Remonumentation Peer Group on November 19, 1998. Position of the drill hole in stone is accepted as a carefull and faithful perpetuation of the position of the original corner. Set 30" Harrison Monument in a Monument Box over drill hole.


Witness Ties:

SE corner of brick Twp. Hall Building N 15 W 109.11'
NW corner of concrete building foundation S 45 E 67.36'
NE corner of brick building S 50 W 52.21'
Set Mag. Nail in P.P. N 34 E 50.08'

Signed by Gary D. Hahn
Surveyor's Michigan License No. 38116

Date 12/08/98

FORM APPROVED BY MICHIGAN STATE BOARD OF PROFESSIONAL SURVEYORS,
JAN. 28, 1971
REVISED MAY 14, 1975
REVISED JAN, 1993 REVISED OCT., 1995

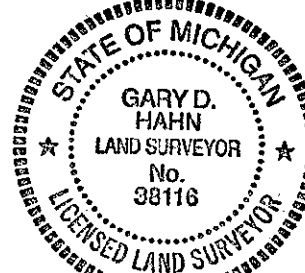

RATIFIED
BY KALAMAZOO COUNTY
REMONUMENTATION
PEER GROUP

11/19/98

R. E. S.