JUL 2 3 1997

LIBER

2PAGE 149

COMMISSION

LAND CORNER RECORDATION CERTIFICATE Filing Requirement of Act 74, Mich. P.A. 1970

For corners in Brady Twp.


Kalamazoo	Located In:	Corner Code #
(County)		
1. Public Land Survey	T <u>4S</u> R T R T R	10WE-11
Property Controlling in Section Miscellaneous Property in Sec	S TR S TR S TR	

Register of Deeds Stamp & File Number

f. Lot No	, Recorded Plat
5. Private Claims	

I. <u>Robert E. Snell</u>, in a field survey on <u>April 2</u>, 19 <u>97</u> do hereby state that under requirements of P.A. 74, Michigan P.A. of 1970, the corner points mentioned in lines 1 and 2 above were in conformance with regulations and rules therefore as required in the current manual of survey instructions of the United States Department of the Interior, Bureau of Land Management or by a decree of a Court of Law and /or that the corner points mentioned in lines 3, 4 and 5 above were in conformance with the rules of the Michigan Board of Land Surveyors or by a Decree of a Court of Law; established, re-established, monumented, recovered, found as expressed below:

NOTE: Not more than 2 corners, all in the same town and range, may be recorded on this certificate.

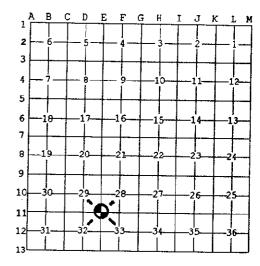

A. Description of original monument and accessories and/or subsequent restoration:

1826: United States Government Surveyors; set post to Sections 28, 29, 32 & 33.

W. Oak 13"


S. 07½ W. N. 070 W.

94 1ks.

14 7ks.

1875: Ed Strong, County Surveyor; Southwest corner W. Oak 6" N. 65½ E. 59 Iks. and stone from U.S. stump.

B. Description of corner evidence found and/or method applied in restoring or reestablishing corner:

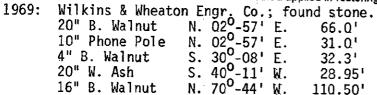

RATIFIED BY KALAMAZOO COUNTY REMONUMENTATION PEER GROUP 4-17-1997

Found stone at intersection of 3 of above witnesses with glass and several small stones around, stone was $8" \times 15" \times 15"$. A 1" iron pipe was located N. 13^{o} -42' W. 1997: 10.16'. Ingersoll, Watson & McMachen used pipe in 1991 survey.

C. Description of monument for corner and accessories established to perpetuate locating the position of the corner:

Southwest corner, Section 28, T. 4 S., R. 10 W., ratified by Kalamazoo County Remonumentation Program Peer Group on April 17, 1997 and is accepted as a careful and faithful perpetuation of the position of the original corner. Found 8" \times 15" \times 15" stone, tapered to the top as set by Ed Strong, County Surveyor in 1875 survey. Removed stone and replaced with a 20" Harrison Monument set 4" below surface of the road.

N. 03⁰ 28" Walnut Exist. Nail/Tab in East Side s. 34° PK Nail in East Side PK Nail in North Side 16" Walnut Ε. 32.05' 10" Twin Ash S. 680 W. 50.60' 24" Walnut N. 76° Exist, Hail/Tab in South Side 110,35 1/ohnt E. En

Signed by

Surveyor's Michigan License No. 9734 Date