

SURVEY & REMONUMENTATION

AUG 06 1996
COMMISSION

LAND CORNER RECORDATION CERTIFICATE
Filing Requirement of Act 74, Mich. P.A. 1970

For corners in
Kalamazoo
(County)
Schoolcraft Twp.

Located In:

Corner Code #

- | | | | |
|------------------------------------|---------------|----------------|-------------|
| 1. Public Land Survey | T <u>4</u> S. | R <u>11</u> W. | <u>D-09</u> |
| | T | R | |
| | T | R | |
| | T | R | |
| 2. Property Controlling in Section | S | T | R |
| | S | T | R |
| 3. Miscellaneous | S | T | R |
| Property in Section | S | T | R |

STATE OF MICHIGAN
COUNTY OF KALAMAZOO
RECEIVED FOR RECORD
96 MAR 23 PM 1 48
CLERK - REGISTER
LIBER 2PAGE 012

Register of Deeds Stamp & File Number

4. Lot No. _____, Recorded Plat _____
5. Private Claims _____

I, Robert E. Snell, in a field survey on April 9, 19 96, do hereby certify that under requirements of P.A. 74, Michigan P.A. of 1970, the corner points mentioned in lines 1 and 2 above were in conformance with regulations and rules therefore as required in the current manual of survey instructions of the United States Department of the Interior, Bureau of Land Management or by a decree of a Court of Law and/or that the corner points mentioned in lines 3, 4 and 5 above were in conformance with the rules of the Michigan Board of Professional Surveyors or by a Decree of a Court of Law; established, re-established, monumented, re-monumented, recovered, found as expressed below:


NOTE: Not more than 4 corners, all in the same town and range, may be recorded on this certificate.

A. Description of original monument and accessories and/or subsequent restoration:

- 1826: United States Government Surveyors; set 1/4 post common to Section 20 and 29 in prairie and raised mound.
1889: F. Hodgman, County Surveyor; found stone from former survey at intersection of fences. Set post.

B. Description of corner evidence found and/or method applied in restoring or reestablishing corner:

- 1996: Found tile on Northeast side of large stone.

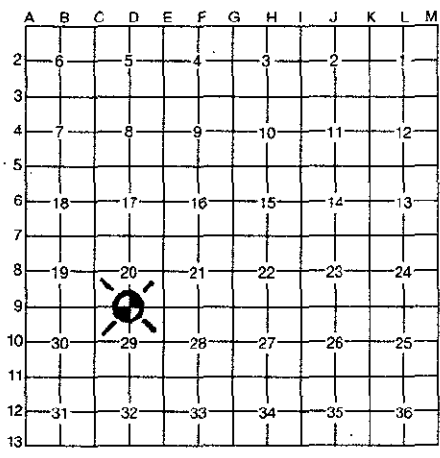

RATIFIED
BY KALAMAZOO COUNTY
REMONUMENTATION
PEER GROUP
5-16-1996
R.E.S.

C. Description of monument for corner and accessories established to perpetuate locating the position of the corner:

- D-09: 1/4 post Common to Sections 20 and 29, T. 4 S., R. 11 W., Ratified by the Kalamazoo County Remonumentation Program Peer Group on May 16, 1996 and is accepted as a careful and faithful perpetuation of the position of the original corner.. Found 3" round tile with cross on top as set by F. Hodgman, County Surveyor in a remonumentation survey in 1889. Set remonumentation sleeve over tile.

- | | | |
|-------------------------------------|-----------|--------|
| Southeast corner steel fence post | N. 15° E. | 1.98' |
| PK Nail on East Side of 20" Walnut | S. 02° E. | 53.15' |
| PK Nail on West Side of 10" Walnut | N. 08° W. | 23.18' |
| PK Nail on South Side of 10" Walnut | N. 81° W. | 18.93' |

Signed by Robert E. Snell
Surveyor's Michigan License No. 9734

Date 5-23-96