

LAND CORNER RECORDATION CERTIFICATE

Filing Requirement of Act 74, Mich. PA 1970

For Corners In:

Lake (County)	Located In	Corner Code #
1. Public Land Survey	T _____ R _____	_____
2. Property Controlling in Section	S <u>7</u> T <u>18N</u> R <u>12W</u>	<u>2</u>
	S <u>7</u> T <u>18N</u> R <u>12W</u>	<u>7</u>
3. Miscellaneous Property in Section	S _____ T _____ R _____	_____
	S _____ T _____ R _____	_____


4. Lot No: _____ Recorded Plat: _____

5. Private Claims: _____

I, Craig W. McVean, in a field survey on April 25, 2011 do hereby state that under requirements of PA 74, Michigan PA of 1970, the corner points mentioned in lines 1 and 2 above were in conformance with regulations and rules therefore as required in the current manual of survey instructions of the United States Department of the Interior, Bureau of Land Management or by a decree of a Court of Law and/or that the corner points mentioned in lines 3, 4 and 5 above were in conformance with the rules of the Michigan Board of Land Surveyors or by a Decree of a Court of Law, established, re-established, monumented, recovered, found as expressed below:

NOTE: Not more than 2 corners, all in the same town and range, may be recorded on this certificate.

Register of Deeds Stamp & File Number

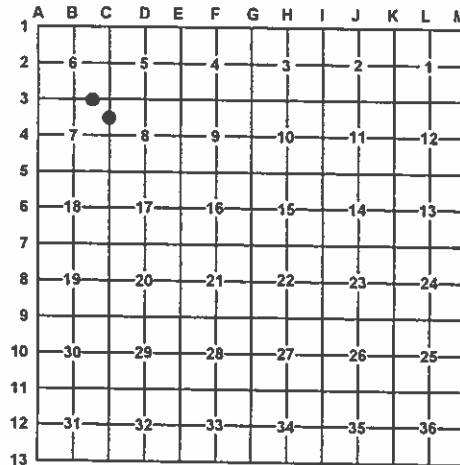

A. Description of original monument and accessories and/or subsequent restoration:

2 - 1965 - Unrecorded survey #1057-65, G. Blass, PS #5489 - iron survey marker.

7 - 1972 - LCRC L. 2, P. 114 - C. F. Roser, PS #12028.
Established corner per standard BLM instructions. Set 1" X 36" Pipe (6" deep). - 1) B. Oak 3" N55°E 18.5', 2) B. Oak 7" S10°E 57.9', 3) CL N-S sand road Due West 6'

B. Description of corner evidence found and/or method applied in restoring or re-establishing corner:

2 - E. 1/16 Corner common to Section 6 & 7. Found 'T' Iron 3± North of centerline E-W gravel road. 'T' iron accepted as the best available evidence of the position of the corner.

7 - North 1/16 corner common to Section 7 & 8 - Found 1" Pipe 6± East of centerline sand N-S road. Found witnesses #2 supporting position. 1" pipe accepted as the best available evidence of the position of the corner.

C. Description of monument for corner and accessories established to perpetuate locating the position of the corner:

2 - 'T' Iron
N45°E 48.27' to set Nail & Tag in SE. side 7" Oak
South 32.93' to Fd.Blass 'T' Iron and add Blue Carsonite Post with location tag
S32°W 68.99' to set Nail & Tag in NW. side 16" W. Pine
N67°W 76.66' to set Nail & Tag in N. side 22" W. Pine

7 - 1" Pipe
S16°E 59.25' to set Nail & Tag in W. side 5" R. Maple
S24°W 81.50' to set Nail & Tag in W. side 11" R. Maple
West 33.00' to a set 2" Alum. Cap on a 5/8" x 34" rebar on line w/ Blue Carsonite Post with location tag
N24°W 86.80' to set Nail & Tag in W. side 9" R. Maple

Signed by:

Craig W. McVean

Date:

10/25/2011

Surveyor's Michigan License No.:

39088

