

LAND CORNER RECORDATION CERTIFICATE


Filing Requirement of Act 74, Mich. PA 1970

For Corners In:

Lake  
(County)

Located In

Corner Code #

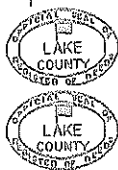

RECEIVED  
05/05/2014 3:56:21 PM  
LAKE COUNTY, MICHIGAN  
SHELLY MYERS, CLERK/REGISTER/CFO

RECORDED  
05/05/2014 3:56:18 PM  
LAKE COUNTY, MI  
SHELLY MYERS, REGISTER OF DEEDS

RECEIPT# 5785, STATION 1  
\$14.00 LAND CORNER

1. Public Land Survey T R  
T R  
2. Property Controlling in Section S 15 T 19N R 11W 2  
S 15 T 19N R 11W 9  
3. Miscellaneous Property in Section S T R  
S T R



Liber C8

Page 21

Register of Deeds Stamp & File Number

4. Lot No: Recorded Plat:

5. Private Claims:

I, Joshua R. Davidson, in a field survey on June 27, 2012 do hereby state that under requirements of PA 74, Michigan PA of 1970, the corner points mentioned in lines 1 and 2 above were in conformance with regulations and rules therefore as required in the current manual of survey instructions of the United States Department of the Interior, Bureau of Land Management or by a decree of a Court of Law and/or that the corner points mentioned in lines 3, 4 and 5 above were in conformance with the rules of the Michigan Board of Land Surveyors or by a Decree of a Court of Law; established, re-established, monumented, recovered, found as expressed below:

NOTE: Not more than 2 corners, all in the same town and range, may be recorded on this certificate.

	A	B	C	D	E	F	G	H	I	J	K	L	M
1													
2	6		5		4		3		2		1		
3													
4	7		8		9		10		11		12		
5													
6	18		17		16		15		14		13		
7													
8	19		20		21		22		23		24		
9													
10	30		29		28		27		26		25		
11													
12	31		32		33		34		35		36		
13													


A. Description of original monument and accessories and/or subsequent restoration:

2 – E 1/16 corner common to sections 10 & 15

9 – CE 1/16 corner section 15

1986 – LCRC – Liber 3, Page 13 – C. Roser, PS #12028  
– Established NE cor of NW¼ of NE¼ of Sec. 15 midway  
& on line between the NE cor & N¼ cor of sec. 15. Set  
5/8" X 34" rerod W/RLS cap & ced post w/loc. tag. –  
1) 6" soft map N50°W 6.2'  
2) 11" soft map S55°W 12.7'  
3) 6" sug map S80°E 8.9'  
E-W Fn (mostly down) South 28'±

– none

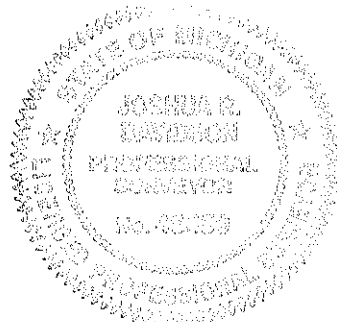

B. Description of corner evidence found and/or method applied in restoring or re-establishing corner:

2 – E 1/16 corner common to sections 10 & 15

9 – CE 1/16 corner section 15

Found 5/8" rebar and accessories #1, 2 & 3 fitting position.  
Added 2" aluminum cap to rebar and is accepted as the best  
available evidence of the position of the corner.

Found ½" X 18" rebar & cap #47956. Replaced it rebar with a  
stamped 2" aluminum cap on 5/8" X 34" rebar and is accepted  
as the best available evidence of the position of the corner.

C. Description of monument for corner and accessories established to perpetuate locating the position of the corner:

2 – a stamped 2" Aluminum Cap on 5/8" x 34" rebar

9 – a stamped 2" Aluminum Cap on 5/8" X 34" rebar

S80°E 8.91' to set nail & tag in S. side 8" S. Maple  
S21°E 22.19' to set nail & tag in E. side 6" Hemlock  
S51°W 13.08' to set nail & tag in NW. side 15" R. Maple  
N52°W 6.44' to set nail & tag in NE. side 8" R. Maple

Set blue Carsonite post with location tag 1' Southwest

N02°E 14.93' to set nail & tag in W. side 3" W. Pine  
N39°E 10.72' to set nail & tag in SE. side 4", 6" & 11" Triple R.  
Maple  
S66°W 26.67' to set nail & tag in NW. side 3" R. Maple  
N41°W 28.38' to set nail & tag in SW. side 14" R. Maple in  
clump of 5

Set blue Carsonite post with location tag 1' Northwest

Signed by:

*Joshua R. Davidson*

Date:

*MAY 5, 2014*

Surveyor's Michigan License No.:

46659