

LAND CORNER RECORDATION CERTIFICATE

Filing Requirement of Act 74, Mich. PA 1970

For Corners In:

Lake
(County)

Located In

Corner Code #



RECEIVED
05/05/2014 3:55:21 PM
LAKE COUNTY, MICHIGAN
SHELLY MYERS, CLERK/REGISTER/CFO



RECORDED
05/05/2014 3:56:18 PM
LAKE COUNTY, MI
SHELLY MYERS, REGISTER OF DEEDS
RECEIPT# 5785, STATION 1
\$14.00 LAND CORNER

1. Public Land Survey	T	_____	R	_____	_____
	T	_____	R	_____	_____
2. Property Controlling in Section	S	20	T	19N	R 11W 1
	S	20	T	19N	R 11W 2
3. Miscellaneous Property in Section	S	_____	T	_____	R _____
	S	_____	T	_____	R _____



Liber C8

Page 16

Register of Deeds Stamp & File Number

4. Lot No: _____ Recorded Plat: _____

5. Private Claims: _____

I, Joshua R. Davidson, in a field survey on June 6, 2012 do hereby state that under requirements of PA 74, Michigan PA of 1970, the corner points mentioned in lines 1 and 2 above were in conformance with regulations and rules therefore as required in the current manual of survey instructions of the United States Department of the Interior, Bureau of Land Management or by a decree of a Court of Law and/or that the corner points mentioned in lines 3, 4 and 5 above were in conformance with the rules of the Michigan Board of Land Surveyors or by a Decree of a Court of Law; established, re-established, monumented, recovered, found as expressed below:

NOTE: Not more than 2 corners, all in the same town and range, may be recorded on this certificate.

	A	B	C	D	E	F	G	H	I	J	K	L	M
1													
2	6		5		4		3		2		1		
3													
4	7		8		9		10		11		12		
5													
6	18		17		16		15		14		13		
7													
8	19		20		21		22		23		24		
9													
10	30		29		28		27		26		25		
11													
12	31		32		33		34		35		36		
13													

A. Description of original monument and accessories and/or subsequent restoration:


1 – W 1/16 corner common to sections 17 & 20

2 – E 1/16 corner common to sections 17 & 20

2001 – Certificate of Survey – Liber 4, Page 527,
– R. Wetherell, PS #24624 – Found 1/2" rebar added cap.

None

2004 – Certificate of Survey – Liber 5, Page 131
– P. Johnson, PS #47956 – Found 1/2" capped iron marked
PS #24624.

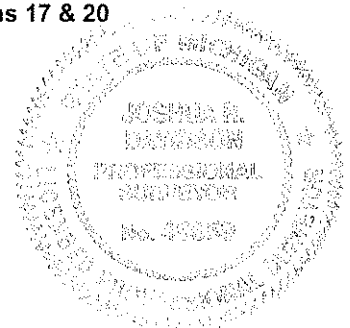

B. Description of corner evidence found and/or method applied in restoring or re-establishing corner:

1 – W 1/16 corner common to sections 17 & 20

2 – E 1/16 corner common to sections 17 & 20

Found 1/2" X 18" rebar & cap #24624 per Certificate of Surveys L.4, P. 527 & L.5, P.131. Accepted the position of the found 1/2" X 18" rebar and cap as the best available evidence of the position of the corner, and replaced it with a stamped 2" aluminum cap on 5/8" x 34" rebar.

Set stamped 2" aluminum cap on 5/8" X 34" rebar per BLM standard procedure. Corner is located 1' North of the centerline of East-West 2-track.

C. Description of monument for corner and accessories established to perpetuate locating the position of the corner:

1 – a stamped 2" Aluminum Cap on 5/8" x 34" rebar

2 – a stamped 2" Aluminum Cap on 5/8" X 34" rebar

S31°E 24.68' to set nail & tag in W. side 8" J. Pine
S10°W 27.73' to set nail & tag in E. side 3" R. Pine
N75°W 13.76' to set nail & tag in S. side 6" Oak
N19°W 5.60' to set nail & tag in W. side 9" J. Pine

S32°E 39.93' to set nail & tag in NE. side 8" Oak
S28°W 34.87' to set nail & tag in NW. side 11" Oak
N42°W 49.30' to set nail & tag in SW. side 21" Oak
South 33.00' to 2" AC on 5/8" X 34" rebar

Set blue Carsonite post with location tag 1' Southeast

Set blue Carsonite post with location tag 33' South

Signed by:

Joshua Davidson
Surveyor's Michigan License No.: 46659

Date:

MAY 5, 2014