

LAND CORNER RECORDATION CERTIFICATE

FILING REQUIREMENT OF ACT 74, MICH. P.A.1970

FOR CORNERS OF—:	LOCATED IN—:	CORNER CODE NUMBER
1. PUBLIC LAND SURVEY.....	T. 19 N. R. 12 W.	D-1; E-1; F-1; G-1
2. PROPERTY CONTROLLING IN SECTION.....	T. N. S. R. E. W.	
3. MISCELLANEOUS PROPERTY IN SECTION.....	T. N. S. R. E. W.	
4. LOT NO., RECORDED PLAT		
5. PRIVATE CLAIMS		

REGISTER OF DEEDS STAMP AND FILING NUMBER

I, Carl F. Roser do hereby certify that under requirements of P.A. 74, Michigan P.A. of 1970, the corner points mentioned in lines 1 and 2 above (identified with circles on index code diagram—over) were, in a field survey on June 20, 1974, established, re-established, monumented, re-monumented, recovered or restored as expressed below and in conformance with regulations and rules therefore as required in the current manual of survey instructions of the United States Department of the Interior, Bureau of Land Management or by a decree of a court of law. Furthermore, that the corner points mentioned in lines 3, 4 and 5 above were, in a field survey on 19, found, recovered, restored, established or re-established as expressed below and in conformance with the rules of the Michigan State Board of Registration for Land Surveyors or, by a Decree of a Court of law:

~~A. Description of original monument and accessories and/or subsequent restoration:~~

C. (continued)

G-1
Found iron & added DNR monument
& cedar post
5" Maple S45°E 29.4
5" Maple S15°W 16.8
SE Sec. 33 S89°54'W 49.50

B. Description of corner evidence found and/or method applied in restoring or re-establishing corner:

- D-1 Restored corner per standard B.L.M. instructions.
- E-1 Recovered 3/4" x 27" bolt for NE corner of Section 5.
- F-1 Restored corner per standard B.L.M. instructions.
- G-1 Found and accepted iron.

C. Description of monument for corner and accessories established to perpetuate locating the position of the corner:

D-1	E-1	F-1
Set DNR monument & cedar post	3/4x27" bolt (buried), added	Set DNR monument & cedar post
5" Maple N88°E 12.9	DNR monument	9" Oak S55°E 43.5
12" W. Pine N55°E 57.9	4" W. Pine S15°E 44.5	4" J. Pine S55°W 23.7
S 1/4 Sec. 32 (20-12)	3" W. Pine S37°W 26.2	Center E-W Trail Due S 50'
S89°04'W 33.28	Set cedar post w/loc. tag	S 1/4 Sec. 33 (20-12)
	Due S 33'	S89°38'W 42.92
	SE corner Sec. 32 (20-12)	
	S89°38'W 36.30	

SIGNED BY Carl F. Roser DATE 8-8-74

SURVEYOR'S MICHIGAN REGISTRATION NO. 12028


FOR STATE AND UNITED STATES AGENCIES:

SIGNED BY _____ DATE _____

CHIEF OF SURVEY PARTY

APPROVED AND SIGNED BY _____ DATE _____

MICHIGAN REGISTERED LAND SURVEYOR

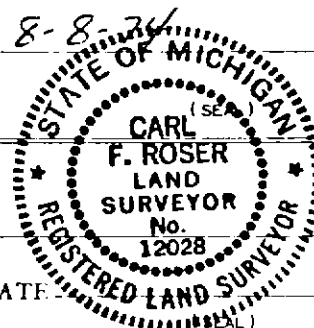

SOUTH NEWKIRK TOWNSHIP
LAKE COUNTY