


LAND CORNER RECORDATION CERTIFICATE
Filing Requirement of Act 74, Mich. PA 1970

Form with fields for Lake (County), Located In, Corner Code #, and numbered sections 1-5 for survey details and private claims.

Register of Deeds Stamp & File Number

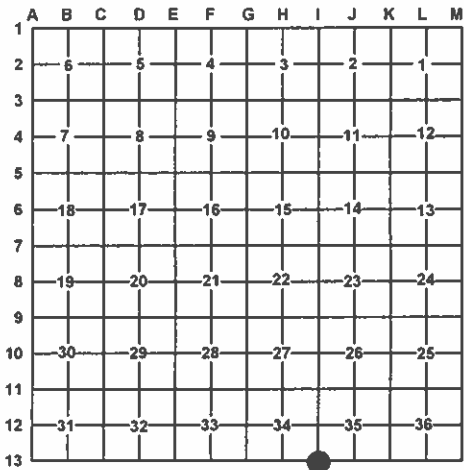

A. Description of original monument and accessories and/or subsequent restoration:

I-13 - 1837 - GLO - J. Hodgson - Set Post
1) Pine 26" N60°E 58 L.
2) W Oak 8" N42°W 27 L.
- 1973 - LCRC - L.2, p. 152 - C. F. Roser (PS #12028)
Reestablished corner per Standard BLM instructions.
Set DNR Mon. and Cedar gd. post.
3) 9" R. Oak N8°E 18.3';
4) 7" R. Oak N40°W 9.4';
5) Cor. to 2 & 3 due East 30.23'

B. Description of corner evidence found and/or method applied in restoring or re-establishing corner:

I-13 - Standard corner common to Sections 34 & 35, T19N, R12W - Fd. broken Dept. of Conservation (DOC) alum. cap on bent over 1" x 36" long galv. iron pipe. No GLO evidence. Witnesses #3 & #4 are stumps, witness #5 is OK but had broken cap. Replaced broken & bent DOC monument with DNR monument at record distance from 'I-1', T18N, R12W on standard line. DNR monument accepted as a careful & faithful reestablishment of the position of the original corner.

C. Description of monument for corner and accessories established to perpetuate locating the position of the corner:

I-13 - Stamped 4" DNR aluminum cap on 1" x 36" long galv. iron pipe.
Set Blue Composite Post 1' North.
East 30.23' to I1, T18N, R12W - DNR monument (Replaced Broken DOC Mon.)
N5°E 11.20' to set nail & tag in W side 2" R Maple
S11°W 16.81' to set nail & tag in W side 5" R Maple scribed 'XBT'
S36°E 38.97' to set nail & tag in NE side tw. 4" R Maple



Signed by: [Signature]
Surveyor's Michigan License No.: 39088

Date: 8/12/2014