

LAND CORNER RECORDATION CERTIFICATE
Filing Requirement of Act 74, Mich. PA 1970


Form with sections for Lake County, Public Land Survey, Property Controlling in Section, and Miscellaneous Property in Section. Includes fields for Located In (T, R, N, S) and Corner Code #.

4. Lot No: Recorded Plat:
5. Private Claims:

I, Craig W. McVean, in a field survey on May 28, 2013 do hereby state that under requirements of PA 74, Michigan PA of 1970, the corner points mentioned in lines 1 and 2 above were in conformance with regulations and rules therefore as required in the current manual of survey instructions of the United States Department of the Interior, Bureau of Land Management or by a decree of a Court of Law and/or that the corner points mentioned in lines 3, 4 and 5 above were in conformance with the rules of the Michigan Board of Land Surveyors or by a Decree of a Court of Law; established, re-established, monumented, recovered, found as expressed below:

NOTE: Not more than 2 corners, all in the same town and range, may be recorded on this certificate.

Register of Deeds Stamp & File Number

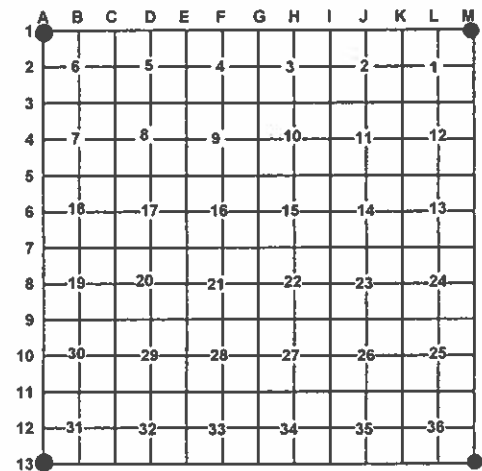

A. Description of original monument and accessories and/or subsequent restoration:

M13 - M1 - A13 & A1 - 1837 - GLO - J. Hodgson - Set Post
1) 8" W. Oak S44°E 19 L.; 2) 10" Pine N24°E 26 L.
- 1910± - CSR - 3) 12" W. Oak S53½°W 124 L. ;
4) 10" Y. Pine N50½°W 155 L.
- 1973 - CSR - G. Johnson (PS #504) Fd. old corner.
Set new 1 ¼" x ¼" iron wagon box rod
5) Y. Pine 16" N80°W 89.8'; 6) B. Oak 9" S51°W 107.2'
- 1935± - Frank Jones F. B.
7) Yellow Pine 12" S80°W 72.9'
5) Yellow Pine 15" N80°W 89½'
- 1973 - LCRC L. C2, p. 15 - C. F. Roser (PS #12028) - Recovered
irons and NBT's. Old corner of record per G. Johnson and F. Jones
Surveys. Corner on W'ly edge of N-S sand road.
8) 22" R. Pine N55°W 89.3'; 5) 22" R. Pine N80°W 89.0';
9) NW leg stl twr #3943 S15°E 158.4';
10) Cedar post with loc. tag due W. 33'
- 2006 - LCRC L. 6, p. 270 - R. L. Wetherell (PS #24624) -
Fd. Roser DNR Monument on the W'ly edge of N-S dirt
road, 45.5' west of center N-S steel tower line.
11) 28" R. Pine N43°W 136.45 (60d spike in NE side);
9) NW Corner tower leg S8°E 158.74' (center bolt head
brace angle iron); 12) 22" W. Oak N85°E 105.10' (60d
spike in N. side); 13) 10" W. Oak S59°E 107.64' (60d spike
in S. side)

B. Description of corner evidence found and/or method applied in restoring or re-establishing corner:

M13 - M1 - A13 & A1 - Township corner common to Sec. 36, T19N, R12W; Sec. 1, T18N, R12W; Sec. 31, T19N, R11W & Sec. 6,
T18N, R11W - Fd. 4" Dept. of Conservation (DOC) Aluminum Cap on 1" iron pipe buried on West edge of N-S sand road. Also
found 2 irons alongside the monument. Centerline of N-S sand road is 9± East. Centerline of rebuilt powerline is 45± East.
Condition of witnesses as follows: #1 to 7 are gone; #8 - Fd. stub - 90.4' to Centerline; #9 & 10 are gone; #11 - Fd. stump;
#12 & 13 are OK. DOC Monument accepted as the best available evidence of the position of the original corner.

C. Description of monument for corner and accessories established to perpetuate locating the position of the corner:

M13 - M1 - A13 & A1 - Add coffee can with concrete around 4" DOC Aluminum Cap Monument. 0.5' below grade. Set Blue Composite
Post with location tag 20' West.
East 33.05' to fd. ½" rebar
N68°E 105.15' to fd. 60d nail in N. side 22" W. Oak (#12)
S65°E 107.63' to fd. 60d nail in S. side 22" W. Oak (#13)
N34°W 93.22' to set nail & tag in SW side 11" R. Pine



Signed by: [Signature]
Surveyor's Michigan License No.: 39088

Date: 8/12/2014