

SURVEY &  
REMONUMENTATION

MAR 23 2000

SECTION

REMONUMENTATION

LAND CORNER RECORDATION CERTIFICATE  
Filing Requirement of Act 74, Mich. P.A. 1970  
GOODLAND TOWNSHIP

For corners in

LAPEER  
(County)

Located In:

Corner Code #

1. Public Land Survey

T 8 N R 12 E

A-7

T R

T R

T R

2. Property Controlling  
in Section

S T R

S T R

3. Miscellaneous

S T R

Property in Sec.

S T R

4. Lot No. , Recorded Plat

5. Private Claims

I, SHELBY W. MONEY, in a field survey on September 25, 19 99 do hereby certify that under requirements of P.A. 74, Michigan P.A. of 1970, the corner points mentioned in lines 1 and 2 above were in conformance with regulations and rules therefore as required in the current manual of survey instructions of the United States Department of the Interior, Bureau of Land Management or by a decree of a Court of Law and /or that the corner points mentioned in lines 3, 4 and 5 above were in conformance with the rules of the Michigan Board of Land Surveyors or by a Decree of a Court of Law; established, re-established, monumented, re-monumented, recovered, found as expressed below:

**NOTE: Not more that 4 corners, all in the same town and range, may be recorded on this certificate.**

A. Description of original monument and accessories and/or subsequent restoration:

GLO Post set by Wampler in 1822 123 Lnks north of M-7 T8N, R11E

1. L2, Pg 475, October 1973 survey by Kay Engineering, not identified. A-7, T8N, R12E
2. L3, Pg 101, June 1975 an LCRC by Bernard Henderson, Found 1/2" iron. A-7, T8N, R12E
3. L3, Pg 393, June 1975 survey by Bernard Henderson, Found 1/2" iron rod. A-7, T8N, R12E
4. L5, Pg 209, December 1994 an LCRC by Thomas Bailey, Found 1/2" iron. M-7, T8N, R11E

B. Description of corner evidence found and/or method applied in restoring or reestablishing corner:

Found a 1/2" rerod in Summers Road (gravel) road at the intersection with Lyons Road to the East. The corner is in physical centerline of the roads 4" below surface.


Witness found: From items 1 & 2  
S 55°W 54.76' T.P.  
From items 4  
South 89.45 to M-7 T8N, R11E.

C. Description of monument for corner and accessories established to perpetuate locating the position of the corner:

A-7 We placed a standard Lapeer County Remonumentation Brass cap on the found 1/2" rebar stamped #30092 as the best location for this corner as accepted by the Professional Surveyors in this area.

AZ 65° 66.60' Set mag nail with Lapeer County remon tag in Southeast face utility pole.  
AZ 110° 118.19' Set mag nail with Lapeer remon tag in Southwest face quad 7" x 3" Maple.  
AZ 220° 54.48' Set mag nail with Lapeer remon tag in East face Michigan Bell Telephone pole.  
AZ 330° 52.98' Set mag nail with Lapeer remon tag in Northeast face 7" Aspen.  
South 89.44' to M-7 T8N, R11E.  
North 2643.23 to A-6  
South 2660.43 to A-8

Signed by S. Shelby W. Money  
Surveyor's Michigan License No. 30092

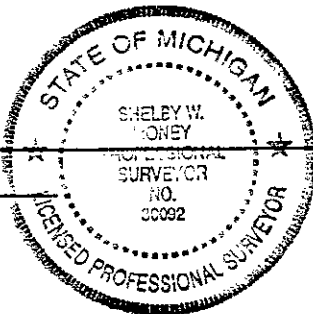

Date 12/25/99

RECEIVED FOR RECORD

00 JAN 19 AM 8:49

*Melissa De Vaughn*  
REGISTER OF DEEDS  
LAPEER COUNTY, MICHIGAN

Register of Deeds Stamp & File Number

	A	B	C	D	E	F	G	H	I	J	K	L	M
1													
2	6		5		4		3		2		1		
3													
4	7		8		9		10		11		12		
5													
6	18		17		16		15		14		13		
7													
8	19		20		21		22		23		24		
9													
10	30		29		28		27		26		25		
11													
12	31		32		33		34		35		36		
13													

DEED GROUP  
APPROPRIATE CORNER

*[Signature]*  
DATE 11-10-99