

SURVEY &
REMONUMENTATION

MAR 13 1998

SECTION

LAND CORNER RECORDATION CERTIFICATE
Filing Requirement of Act 74, Mich. P.A. 1970
GOODLAND TOWNSHIP

RECEIVED FOR RECORD

98 JAN -7 PM 3:04

For corners in

LAPEER
(County)

Located In:

Corner Code #

1. Public Land Survey

T 8 N R 12 E

A-13

2. Property Controlling
in Section

S
S

T R
T R

3. Miscellaneous
Property in Sec.

S
S

T R
T R

4. Lot No. _____, Recorded Plat _____

5. Private Claims _____

I, WILLIAM E. SODERBERG, in a field survey on May 7, 19 97 do hereby
certify that under requirements of P.A. 74, Michigan P.A. of 1970, the corner points mentioned in lines 1 and 2
above were in conformance with regulations and rules therefore as required in the current manual of survey
instructions of the United States Department of the Interior, Bureau of Land Management or by a decree of a
Court of Law and /or that the corner points mentioned in lines 3, 4 and 5 above were in conformance with the
rules of the Michigan Board of Land Surveyors or by a Decree of a Court of Law, established, re-established,
monumented, re-monumented, recovered, found as expressed below:

NOTE: Not more than 4 corners, all in the same town and range, may be recorded
on this certificate.

A. Description of original monument and accessories and/or subsequent restoration:

- | | | |
|--------------------|------------------------|---|
| 1. GLO 1816 | Joseph Wampler | Set post No witnesses remain |
| 2. Survey 5/18/84 | R. Kay #14096 | L6, P.704 Found 1/2" Iron M-1 Attica |
| 3. Survey 8/30/88 | L. Bates #16699 | L.8, P.31 Found 1/2" Iron M-1 Attica |
| 4. Survey 2/20/89 | H. Elrich #18986 | L.8, P.326 Found 1/2" Iron M-1 Attica |
| 5. Survey 11/13/91 | H. Elrich #18986 | L.9, P.591 Found 1/2" Iron M-1 Attica |
| 6. Survey 2/17/92 | H. Elrich #18986 | L.9, P.783 Found 5/8" Iron in mon box M-1 Attica |
| 7. LCRC 1/5/94 | J. Niederhauser #24608 | Set Brass Remon disk in existing monument box for M-13 Arcadia Township |

B. Description of corner evidence found and/or method applied in restoring or reestablishing corner:

Found a standard lapeer County Remon cap stamped M-13 #24608 in mpmument box 4" below the surface of asphalt road. The
corner is in the centerline of Bowers Road (asphalt) East and West and Summers Road (gravel) to the North and South

The found corner is Common with M-13 Arcadia T.8N.,R11E.; A-1 Imlay Township T.7N.,R12E. And M-1 Attica Township
T.7N.,R11E.

Witness found: From items 2, 3, 4 and 5, S.30° E 61.98' Nail in fence post
From item 6 S.30°E. 60.90 PK nail in corner fence post
From item 7 NW 114.96' nail/remon tag in East face 6" Birch
NE 129.88 nail/remon tag in West face 6" Ash
SE 61.00 nail/remon tag in West face fence post

Distances: A-1 to A-2 2958.50 Imlay Township


C. Description of monument for corner and accessories established to perpetuate locating the position of the corner:

We placed a standard Lapeer County Remonumentation Brass cap on the found 1/2" rebar stamped #17635 as the best location for
this corner as accepted by the Professional Surveyors in this area.

N. 25° W. 114.96' Set PK/Lapeer County remon tag in East face 6" Birch
N. 20° E. 129.88' Found PK/Lapeer County remon tag in West face 6" Ash
S. 15° E. 99.27' Set PK/Lapeer County remon tag in West face 36" Oak
S. 45° W. 183.17' Northeast corner House

Signed by William E. Soderberg Date November 18, 1997

Surveyor's Michigan License No. 17635

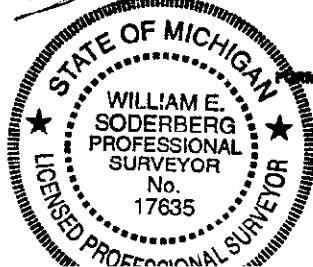

Melissa DeVough
REGISTER OF DEEDS
LAPEER COUNTY, MICHIGAN

Register of Deeds Stamp & File Number

	A	B	C	D	E	F	G	H	I	J	K	L	M
1													
2	6			5			4			3		2	1
3													
4	7			8			9			10		11	12
5													
6	18			17			16			15		14	13
7													
8	19			20			21			22		23	24
9													
10	30			29			28			27		26	25
11													
12	31			32			33			34		35	36
13													

LAPEER GROUP
APPROVED LAND CORNER
JAN 13 OF 1998
LAPEER COUNTY
RAY DAVIS P.E. CO. SURVEYOR
DATE 10-13-97

LIBER 0006 PAGE 0013