

MAR 15 2000

SECTION

LAND CORNER RECORDATION CERTIFICATE
Filing Requirement of Act 74, Mich. P.A. 1970

For corners in


Leelanau (County) Located In: Corner Code #
1. Public Land Survey T 31N R 11W F-5 (Leelanau)
2. Property Controlling in Section S T R
3. Miscellaneous Property in Sec. S T R

Barbara Kirt 12/29/99
Leelanau Res of Deeds 4:11 PM
BJK Fee: 9.00
04B00002 P0349 Page 1 of 1
#652
Register of Deeds Stamp & File Number

4. Lot No. , Recorded Plat
5. Private Claims

I, David T. Rowe, in a field survey on November 29, 1999 do hereby state that under requirements of P.A. 74, Michigan P.A. of 1970, the corner points mentioned in lines 1 and 2 above were in conformance with regulations and rules therefore as required in the current manual of survey instructions of the United States Department of the Interior, Bureau of Land Management or by a decree of a Court of Law and/or that the corner points mentioned in lines 3, 4 and 5 above were in conformance with the rules of the Michigan Board of Land Surveyors or by a Decree of a Court of Law; established, re-established, monumented, recovered, found as expressed below:

NOTE: Not more than 2 corners, all in the same town and range, may be recorded on this certificate.

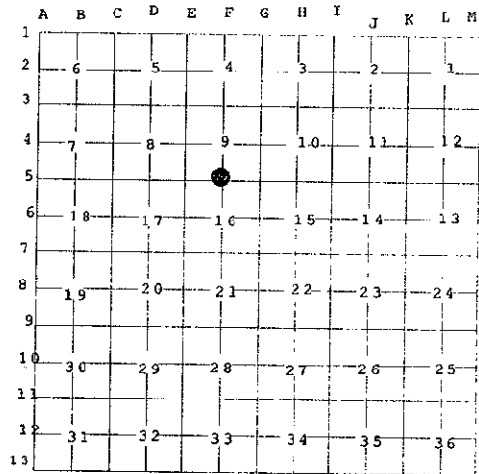


A. Description of original monument and accessories and/or subsequent restoration:
F-5: 1/4 Corner Common to Sections 9 and 16:
G.L.O. Notes: 1851 Set 1/4 Section Post. 9" Beech N31°W 32 lks., 12" Beech S26°E 13 lks.
County Records: 1990 J. Korr, Fd. 5/8" Re-Bar. 8" Maple S58°E 50.15', 20" Triple Maple S17°E 16.28', 6" Maple N25°E 10.30', Fence Post N22°E 0.90'.
1992 S. Smith, Fd. 5/8" Iron. Same witness as J. Korr.
1993 N. O'Non, Fd. 5/8" Iron rod. 4" Maple N26°E 10.30', 30" Maple S15°E 16.31', 16" Maple N64°W 65.52', 3" Maple East 19.16'.

B. Description of corner evidence found and/or method applied in restoring or reestablishing corner:
F-5: 1/4 Corner Common to Sections 9 and 16:
Fd. 5/8" Re-Rod. Old Fence North and East.

APPROVED LAND CORNER
P.A. 345 OF 1990
LEELANAU COUNTY
DATE: 11-30-99
COUNTY REP. W.M. O'Non

C. Description of monument for corner and accessories established to perpetuate locating the position of the corner:
F-5: 1/4 Corner Common to Sections 9 and 16:
Found 5/8" Re-Rod accepted as a careful and faithful re-establishment of the position of the original corner by the Leelanau County Peer Group, November 30, 1999 and replaced with 1/2" i.d. galvanized 36" long iron pipe with a stamped brass cap.

Witnesses:
N27°E 10.25' Fd. Spike W. Face 6" Maple
S15°E 16.32' Fd. Spike NE. Face Triple 24" Maple
S75°W 14.48' Fd. P.K. Nail with Washer # 28417 N. Face 3" Maple
S85°E 19.17' Fd. Nail S. Face 5" Maple
S60°E 0.58' Face of Wood Fence Post

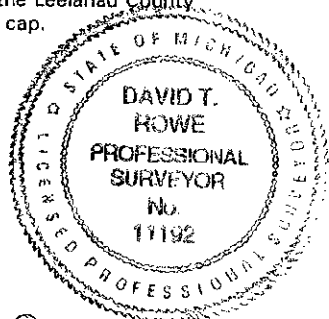

Signed by David T. Rowe
Surveyor's Michigan License No. 11192

Date Dec 22, 1999