

MAY 16 1997

COMMISSION

Filed under Remonumentation Act 345 of 1990

LAND CORNER RECORDATION CERTIFICATE

Filing Requirement of Act 74, Mich. P.A. 1970

LIBER 001 PAGE 126

For corners in

Lenawee
(County)

Located In:

Corner Code #

1. Public Land Survey T - 5 - S R - 1 - E C-1
T R
T R
T R
2. Property Controlling S T R
in Section S T R
3. Miscellaneous S T R
Property in Sec S T R

4. Lot No. _____, Recorded Plat _____
5. Private Claims _____

I, Glenn E. Richard, in a field survey on June 3 19 96, do hereby certify that under requirements of P.A. 74, Michigan P.A. of 1970, the corner points mentioned in lines 1 and 2 above were in conformance with regulations and rules therefore as required in the current manual of survey instructions of the United States Department of the Interior, Bureau of Land Management or by a decree of a Court of Law and/or that the corner points mentioned in lines 3, 4 and 5 above were in conformance with the rules of the Michigan Board of Land Surveyors or by a Decree of a Court of Law; established, re-established, monumented, re-monumented, recovered, found as expressed below:


NOTE: Not more than 4 corners, all in the same town and range, may be recorded on this certificate.

A. Description of original monument and accessories and/or subsequent restoration:

G.L.O. 1824, Robert Clark set post at Intersection 212 lks. W. of post Cor. Sec. 5 & 6, W. Oak 20 S 80 W 33, W. Oak 18 S 78 1/2 E 35
March 1880, G.E. Kedzie, County Surveyor, re-established C-13, T4S-R1E. Drove stake S 31° E 29 1/2 chains from G.L.O. stump and then set stone 2.12 chains West for corner of Sections 5 and 6.
J.L. Richard records same as above.
January 1973, W.E. Frazier and Associates set iron pipe and recorded it in L. 2, P. 387.
Sept. 1980, Ron Keller found the iron pipe and recorded it in L. 4, P. 340.

B. Description of corner evidence found and/or method applied in restoring or reestablishing corner:

August 1994, I found the iron pipe recorded as the corner, dug with a back hoe and found 3/4" X 30" iron bar 2.5 deep on N. edge of pavement 1.2 East and 7.4 North of recorded corner. Replaced the 3/4" iron bar with a 3/4" X 3' gas pipe capped G.E.R. 13040.
June 3, 1996 Found the 3/4" gas pipe under 8" of new asphalt pavement. Set monument box.

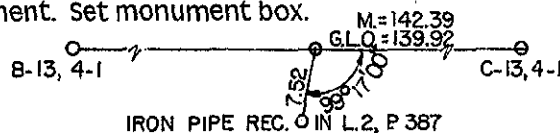

C. Description of monument for corner and accessories established to perpetuate locating the position of the corner:

3/4" X 3' gas pipe capped G.E.R. 13040 in monument box and is accepted as the best available evidence of the position of the original corner.
N 50° W Dbl. hd. nail & disc in 36" Maple 25.11
N 15° E Dbl. hd. nail & disc in 5" Hickory 18.84
S 80° W Dbl. hd. nail & disc in Elec. pole 199.32
South Found iron pipe 40.77
East SE. Cor. Sec. 31, T4S-R1E (C-13) (Jackson County Re-mon corner) 142.39



Ratified by Peer Group in accordance with P.A. 345 Co. Rep. Glenn E. Richard Date 12-18-95
Signed by Glenn E. Richard Date 10-25-96
Glenn E. Richard
Surveyor's Michigan License No. 13040