

SURVEY & MONUMENTATION

Filed under Remonumentation Act 345 of 1990

JAN 22 2001

LAND CORNER RECORDATION CERTIFICATE

Filing Requirement of Act 74, Mich. P.A. 1970

SECTION

For corners in

Lenawee
(County)

Located In:

Corner Code #



LIBER 1

PAGE 406

STATE OF MICHIGAN
LENAWEE COUNTY
FILED
19 SEP 2000 3:06:26 PM
VICTORIA J. DANIELS
REGISTER OF DEEDS

1. Public Land Survey T 6 - S R 4 - E D 8
T R
T R
T R
T R
2. Property Controlling S T R
in Section S T R
3. Miscellaneous S T R
Property in Sec S T R

Register of Deeds Stamp & File Number

4. Lot No. , Recorded Plat
5. Private Claims

I, Glenn E. Richard, in a field survey on August 10, 2000, do hereby certify that under requirements of P.A. 74, Michigan P.A. of 1970, the corner points mentioned in lines 1 and 2 above were in conformance with regulations and rules therefore as required in the current manual of survey instructions of the United States Department of the Interior, Bureau of Land Management or by a decree of a Court of Law and/or that the corner points mentioned in lines 3, 4 and 5 above were in conformance with the rules of the Michigan Board of Land Surveyors or by a Decree of a Court of Law; established, re-established, monumented, re-monumented, recovered, found as expressed below:

| | A | B | C | D | E | F | G | H | I | J | K | L | M |
|----|----|----|----|----|----|----|---|---|---|---|---|---|---|
| 1 | | | | | | | | | | | | | |
| 2 | 6 | 5 | 4 | 3 | 2 | 1 | | | | | | | |
| 3 | | | | | | | | | | | | | |
| 4 | 7 | 8 | 9 | 10 | 11 | 12 | | | | | | | |
| 5 | | | | | | | | | | | | | |
| 6 | 18 | 17 | 16 | 15 | 14 | 13 | | | | | | | |
| 7 | | | | | | | | | | | | | |
| 8 | 19 | 20 | 21 | 22 | 23 | 24 | | | | | | | |
| 9 | | | | | | | | | | | | | |
| 10 | 30 | 29 | 28 | 27 | 26 | 25 | | | | | | | |
| 11 | | | | | | | | | | | | | |
| 12 | 31 | 32 | 33 | 34 | 35 | 36 | | | | | | | |
| 13 | | | | | | | | | | | | | |

NOTE: Not more than 4 corners, all in the same town and range, may be recorded on this certificate.

A. Description of original monument and accessories and/or subsequent restoration:

GLO This position not established by original government surveyors
Unable to find when or how the corner was established
1959 Kenneth Suydam reset center from found iron pipe 3.88 chains (256.08') east
1967 Kenneth Suydam found iron pipe
1968 Werner Sommer found iron pipe on line between E & W 1/4 corners
1971 Kenneth Suydam found iron pipe
1985 Kenneth Suydam shows corner but not type of monumentation
1990 I found iron pipe
1992 Werner Sommer found split seam iron
2000 Steven Young found iron pipe


B. Description of corner evidence found and/or method applied in restoring or reestablishing corner:

August 10, 2000 Kevin Pickford P.S. 46682 Found split seam iron over boat spike under newly paved road. Replaced them with a 5/8" X 3' re-rod with Lenawee County Re-mon capped P.S. 13040 and set monument box. From AES records this corner is on a line between the E & W 1/4 corners and is 3.56' west of a line between the N & S 1/4 corners

C. Description of monument for corner and accessories established to perpetuate locating the position of the corner:

5/8" X 3' re-rod with Lenawee County Re-mon cap stamped P.S. 13040 in monument box. This position not established by original government surveyors. This monument is accepted as the best available evidence of the position of the corner.

Fd. dbl hd nail & disc in NE face of T.P. next to pedestal N 20° W 34.10
Fd. dbl hd nail & disc in NE face of E.P. S 45° E 67.20
Face of chain link fence post S 45° W 41.59
Fd. iron pipe capped GER 13040 against E.P. North 32.76

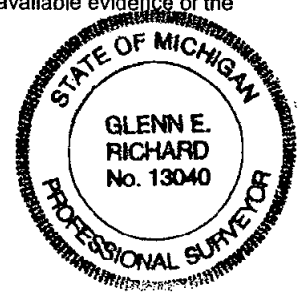

Ratified by Peer Group in accordance with P.A. 345 Co. Rep. Glenn E. Richard Date August 22, 2000

Signed by Glenn E. Richard Date Sept. 15, 2000
Glenn E. Richard

Surveyor's Michigan License No. 13040