

JAN 26 2000

Filed under Remonumentation Act 345 of 1990
LAND CORNER RECORDATION CERTIFICATE
Filing Requirement of Act 74, Mich. P.A. 1970

SECTION

For corners in

Lenawee
(County)

Located In:

Corner Code #

LIBER 1 PAGE 367
STATE OF MICHIGAN
LENAAEE COUNTY
FILED

15 NOV 1999 9:58:12 AM

VICTORIA J. DANIELS
REGISTER OF DEEDS

Register of Deeds Stamp & File Number

1. Public Land Survey T-8-S R-5-E M-7
T R
T R
T R
T R
2. Property Controlling S T R
In Section S T R
3. Miscellaneous S T R
Property in Sec S T R
4. Lot No. _____, Recorded Plat _____
5. Private Claims _____

I, Glenn E. Richard, in a field survey on October 1, 19 99, do hereby certify that under requirements of P.A. 74, Michigan P.A. of 1970, the corner points mentioned in lines 1 and 2 above were in conformance with regulations and rules therefore as required in the current manual of survey instructions of the United States Department of the Interior, Bureau of Land Management or by a decree of a Court of Law and/or that the corner points mentioned in lines 3, 4 and 5 above were in conformance with the rules of the Michigan Board of Land Surveyors or by a Decree of a Court of Law; established, re-established, monumented, re-monumented, recovered, found as expressed below:

NOTE: Not more than 4 corners, all in the same town and range, may be recorded on this certificate.

A. Description of original monument and accessories and/or subsequent restoration:

GLO 1820 Joseph Wampler Set post cor. Sec.'s 13 & 24 Maple 8 N 71 E 12 Ash 15 S 4 W 11
1880 James Blair re-established the corner @ A-7 T8S R6E by bearing and distance from one of the government witness trees. (S 37 E 14 links from cottonwood stump) then measured south on the section line 1.14 and set stake and stones for corner to Sec.'s 13 & 24 T8S R5E.
1881 James Blair found stake & stones.
1887 James Blair found stake & bricks.
1970 I dug and found stones, bricks and pieces of dishes. I raised with 1" iron pipe S.E. cor of hse. SW 45.3 N.E. cor. of hse. NW 48.8
1975 I found 1" iron pipe & recorded it in Liber 3, Page 354. I believe the road commission set a monument box at this time.
1980 Kenneth Suydam found 1" iron pipe.


B. Description of corner evidence found and/or method applied in restoring or reestablishing corner:

Oct. 1, 1999 Found nail at surface in top of 1" X 30" iron pipe. Probed & hit stone on east side of the iron pipe. S.E. corner of house S 85 W 45.1± NE corner of house NW 48.6±. Replaced the iron pipe with 5/8" X 3' re-rod with Lenawee County Re-mon cap stamped P.S. 13040 and set monument box.

C. Description of monument for corner and accessories established to perpetuate locating the position of the corner:

5/8" X 3' re-rod with Lenawee County Re-mon cap stamped P.S. 13040 in a monument box and is accepted as a careful and faithful re-establishment of the position of the original corner.

GBW capped iron North 75.25 (A-7 T8S R6E)
Survey Mark spike & Lenawee County Re-mon tag in Elec. brace pole N 50° E 43.37
dbl. hd. nail and Lenawee County Re-mon tag in 36" Oak S 10 W 91.03
dbl. hd. nail and Lenawee County Re-mon tag in E.P. N 35° W 36.08

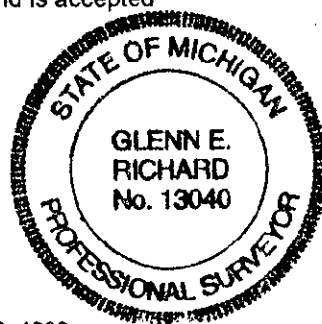

Ratified by Peer Group in accordance with P.A. 345 Co. Rep. Glenn E. Richard Date October 26, 1999

Signed by Glenn E. Richard Date Oct. 29, 1999
Glenn E. Richard

Surveyor's Michigan License No. 13040

FORM APPROVED BY MICHIGAN STATE BOARD OF LAND SURVEYORS, JAN 28, 1971

REVISED MAY 14, 1975

REVISED JAN., 1983

ADAPTED FOR WORD PROCESSING MARCH, 1993