

SURVEY &
REMONUMENTATION

LUCE COUNTY REMONUMENTATION CORNER

APR 28 1995

LAND CORNER RECORDATION CERTIFICATE

Filing Requirement of Act 74, Mich. P.A. 1970

COMMISSION

For corners in
Luce

(County)

Located In:

Corner Code #

Filed 1/20 A.D., 19 95

At 12:30 o'clock P.M.

File No. page 609

Keith R. Waters
Luce County Reg. of Deeds

Register of Deeds Stamp & File Number

1. Public Land Survey

T 45N R 9W A-4 Same
T 45N R 10W M-4 Corner

2. Property Controlling
in Section


S T

3. Miscellaneous
Property in Sec.

S T

4. Lot No. , Recorded Plat

5. Private Claims

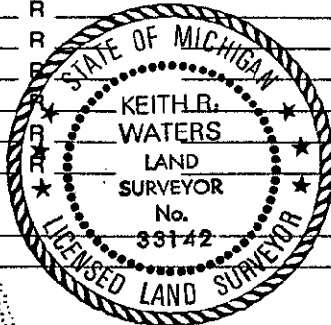

	A	B	C	D	E	F	G	H	I	J	K	L	M
2	6	5	4	3	2	1							
3													
4	7	8	9	10	11	12							
5													
6	18	17	16	15	14	13							
7													
8	19	20	21	22	23	24							
9													
10	30	29	28	27	26	25							
11													
12	31	32	33	34	35	36							
13													

I, Keith R. Waters in a field survey on November 16, 19 94

do hereby certify that under requirements of P.A. 74, Michigan P.A. of 1970, the corner points mentioned in lines 1 and 2 above were in conformance with regulations and rules therefore as required in the current manual of survey instructions of the United States Department of the Interior, Bureau of Land Management or by a decree of a Court of Law and/or that the corner points mentioned in lines 3, 4 and 5 above were in conformance with the rules of the Michigan Board of Land Surveyors or by a Decree of a Court of Law; established, re-established, monumented, re-monumented, recovered, found as expressed below:

NOTE: Not more than 4 corners, all in the same town and range, may be recorded on this certificate.

A. Description of original monument and accessories and/or subsequent restoration:

A-4 1/4 Corner Common to Section 7, T45N, R9W & Section 12, T45N, R10W

Original ties to post: Sugar 13, S27°E 6 links Sugar 10, N41°W 27 links.

1979 - Corner shown on a survey drawing by Thomas Beaudrie, RLS 11359, as being a found bolt in centerline of County Road 403, 85.4 feet south of the centerline of Newman Road. Recorded on page 20, Luce County Certified surveys.

1986 - Corner is shown again by Thomas Beaudrie, survey recorded on page 79, in same location as above.

B. Description of corner evidence found and/or method applied in restoring or reestablishing corner:

A-4 (T45N, R9W)

This corner is being perpetuated as part of the Luce County Remonumentation Program. Found a railroad spike in the centerline of County Road 403, approximately 85 feet south of the centerline of County Road 384 to the west. Position appears to be a perpetuation of corner location after road construction. Corner is 2642.03 feet from section corner to the north, 2640.29 feet from section corner to the south, and is 11.16 feet west of a straight line between said section corners. Accepted corner as found.

C. Description of monument for corner and accessories established to perpetuate locating the position of the corner:

A-4 (T45N, R9W)

Corner is a railroad spike in the centerline of County Road 403, 85 feet south of the intersection of County Road 384 to the west. Witnesses:

36" Cottonwood, S56°E 52.70'
12" Jack Pine, S88°W 53.26'
12" Red Pine, N61°W 71.01'
Power Pole (117-ML2-17),
N31°E 133.17'

Note: Distances are to a nail and tag in side of the witness object. Bearings are compass bearings corrected for declination. Trees have small side blaze at measuring nail only due to location in residential area.

Signed by Keith R. Waters

Date 12-23-94

Surveyor's Michigan License No. 33142