

SURVEY & REMONUMENTATION

LAND CORNER RECORDATION CERTIFICATE Filing Requirement of Act 74, Mich. P.A. 1970 Luce County Remonumentation Corner

MAR 18 2000

For corners in

Luce County

Located in:

Corner Code #

1. Public Land Survey

T45N R12W

G-11/G-12

T

R

T

R

T

R

2. Property Controlling in Section

S

T

R

S

T

R

3. Miscellaneous Property in Sec.

S

T

R

S

T

R

4. Lot No.

, Recorded Plat

5. Private Claims

SECTION

LUCE COUNTY
REGISTER OF DEEDS

Recorded

Liber 3

878

02-08-2000 08:27:32


Kathy S. Mahar, Register

REGISTER OF DEEDS

Register of Deeds Stamp & File Number

I, William L. Karr, in a field survey on November 12, 1999, do hereby state that under requirements of P.A. 74, Michigan P.A. of 1970, the corner points mentioned in lines 1 and 2 above were in conformance with regulations and rules therefore as required in the current manual of survey instructions of the United States Department of the Interior, Bureau of Land Management or by a decree of a Court of Law and /or that the corner points mentioned in lines 3, 4 and 5 above were in conformance with the rules of the Michigan Board of Land Surveyors or by a Decree of a Court of Law; established, re-established, monumented, recovered, found as expressed below:

NOTE: Not more than 2 corners, all in the same town and range, may be recorded on this certificate.

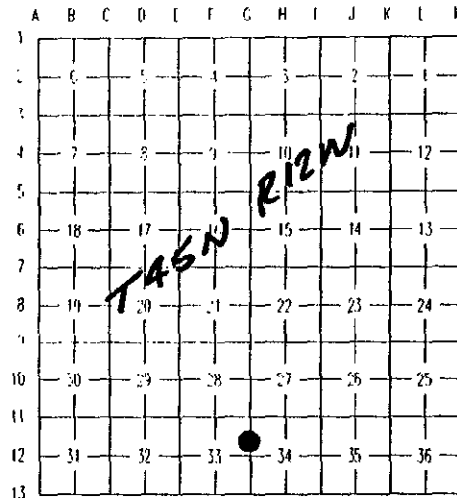

A. Description of original monument and accessories and/or subsequent restoration:

(G-11/G-12) Meander Corner between Sections 33 and 34, Township 45 North, Range 12 West.

1849 G.H. Carleton set post for corner in original survey. Witnesses: Cedar 12" N19°E 43 lks
Cedar 16" N27°W 56 lks.

Found no subsequent survey history on this corner in available public records.

B. Description of corner evidence found and/or method applied in restoring or reestablishing corner:

(G-11/G-12) Meander Corner between Sections 33 and 34, Township 45 North, Range 12 West.
This corner is being perpetuated as part of the Luce County Remonumentation Program.

Found no evidence of the original corner or subsequent restoration. Re-established the corner at the record G.L.O. distance South of Section corner 27,28,33 and 34 on the extension of the Section line to the North.

C. Description of monument for corner and accessories established to perpetuate locating the position of the corner:

(G-11/G-12) Meander Corner between Sections 33 and 34, Township 45 North, Range 12 West.

Corner is a 1/2" x 48" re-rod with a stamped aluminum Luce County Remonumentation cap. Corner falls 7.0 feet more or less North of water's edge.

Witnesses:

Sugar Maple 16"	N41°E	20.00 feet
Red Maple 16"	N74°E	39.33 feet
Cedar 11"	S86°W	20.72 feet
Cedar 10"	N72°W	31.80 feet

Bearings are compass bearings, corrected for declination (6° W), all distances are to a nail and tag in the side of the witness object unless otherwise noted.

Signed by

William L. Karr

Date

12/24/99

Surveyor's Michigan License No. 27450

FORM APPROVED BY MICHIGAN STATE BOARD OF PROFESSIONAL SURVEYORS, JAN. 28, 1971
REVISED MAY 14, 1975
REVISED JAN., 1983
REVISED OCT., 1995

c:\word\lisc\cornerforms\luce\1999\45 12w.g-11-12.doc

OTHER CORNER