

FEB 23 2001


LAND CORNER RECORDATION CERTIFICATE
Filing Requirement of Act 74, Mich. P.A. 1970
Luce County Remonumentation Corner

SECTION

For corners in

Luce County	Located in:	Corner Code #
1. Public Land Survey	T45N R12W	K-11/L-11 (West)
	T R	
	T R	#015
2. Property Controlling in Section	S T R	
3. Miscellaneous Property in Sec.	S T R	
4. Lot No.		Recorded Plat
5. Private Claims		

LUCE COUNTY
REGISTER OF DEEDS
Recorded
Liber 3 page 953
02-12-2001 09:44:18
Kathie S. Mahar, Register
REGISTER OF DEEDS
Register of Deeds Stamp & File Number

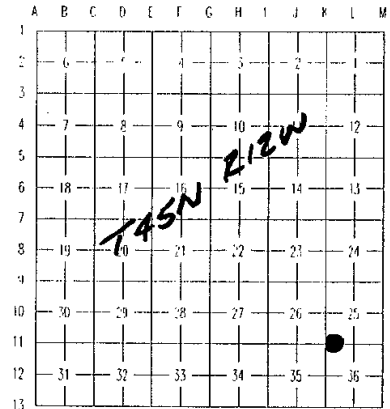

I, William L. Karr, in a field survey on January 27, 2000, do hereby state that under requirements of P.A. 74, Michigan P.A. of 1970, the corner points mentioned in lines 1 and 2 above were in conformance with regulations and rules therefore as required in the current manual of survey instructions of the United States Department of the Interior, Bureau of Land Management or by a decree of a Court of Law and/or that the corner points mentioned in lines 3, 4 and 5 above were in conformance with the rules of the Michigan Board of Land Surveyors or by a Decree of a Court of Law; established, re-established, monumented, recovered, found as expressed below:

NOTE: Not more than 2 corners, all in the same town and range, may be recorded on this certificate.

A. Description of original monument and accessories and/or subsequent restoration:

(K-11/L-11) (West) Meander Corner common to Sections 25 and 36, Township 45 North, Range 12 West

1849 G.H. Carleton, D.S. set post for corner. Tamarack 6 N40W 43
Tamarack 5 N04E 4



B. Description of corner evidence found and/or method applied in restoring or reestablishing corner:

(K-11/L-11) (West) Meander Corner common to Sections 25 and 36, Township 45 North, Range 12 West

This corner is being re-established as part of the Luce County Remonumentation Program.

Found no evidence of the original corner or subsequent restoration. Re-established the corner by single proportionate measurement using Section corner 25, 26, 35 and 36 and 1/4 corner to 25/36. Distance West to Section corner is 1323.61 feet (GLO - 1322.64 feet). Distance East to 1/4 corner is 1318.33 feet (GLO - 1317.36 feet).

C. Description of monument for corner and accessories established to perpetuate locating the position of the corner:


(K-11/L-11) (West) Meander Corner common to Sections 25 and 36, Township 45 North, Range 12 West.

Corner is a 1/2" x 48" re-rod with stamped aluminum Luce County Remonumentation Corner cap. Corner falls 150 feet, more or less West of waters edge.

Witnesses:

Tamarack 6"	N81°E	12.54 feet
Tamarack 5"	S12°E	4.99 feet
Tamarack 8"	S76°W	21.68 feet
Tamarack 6"	N04°W	28.80 feet

Bearings are compass bearings, corrected for declination (6° W),
all distances are to a nail and tag in the side of the witness object unless otherwise noted.

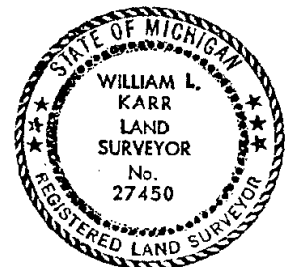

Signed by William L. Karr
William L. Karr, P.S.
Surveyor's Michigan License No. 27450

Date 12/01/00