

FEB 23 2001

LAND CORNER RECORDATION CERTIFICATE
Filing Requirement of Act 74, Mich. P.A. 1970
Luce County Remonumentation Corner

SECTION

For corners in

Luce County

Located in:

Corner Code #

- | | | | | |
|-------------------------|---|-----------|------------|---------------|
| 1. Public Land Survey | | T45N R12W | <u>C-1</u> | Same |
| | | T46N R12W | C-13 | Corner |
| | | T | R | |
| | | T | R | |
| 2. Property Controlling | S | T | R | |
| In Section | S | T | R | |
| 3. Miscellaneous | S | T | R | |
| Property in Sec. | S | T | R | |
| 4. Lot No. | | | | Recorded Plat |
| 5. Private Claims | | | | |

LUCE COUNTY

REGISTER OF DEEDS

Recorded

Liber 3 Page 945


02-12-2001 09:43:00

Kathy S. Mahar

Kathy S. Mahar, Register

REGISTER OF DEEDS

Register of Deeds Stamp & File Number

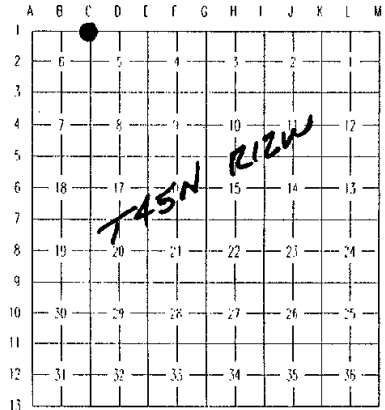


I, William L. Karr, in a field survey on August 2, 2000, do hereby state that under requirements of P.A. 74, Michigan P.A. of 1970, the corner points mentioned in lines 1 and 2 above were in conformance with regulations and rules therefore as required in the current manual of survey instructions of the United States Department of the Interior, Bureau of Land Management or by a decree of a Court of Law and/or that the corner points mentioned in lines 3, 4 and 5 above were in conformance with the rules of the Michigan Board of Land Surveyors or by a Decree of a Court of Law; established, re-established, monumented, recovered, found as expressed below:

NOTE: Not more than 2 corners, all in the same town and range, may be recorded on this certificate.

A. Description of original monument and accessories and/or subsequent restoration:

(C-1) Section corner common to Sections 5 and 6 Township 45 North, Range 12 West, and Sections 31 and 32 Township 46 North, Range 12 West.

1841 W. A. Burt, D.S. set post for corner. Tamarack 7 N20E 14
Tamarack 5 N68W 24

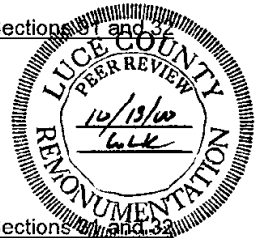

B. Description of corner evidence found and/or method applied in restoring or reestablishing corner:

(C-1) Section corner common to Sections 5 and 6 Township 45 North, Range 12 West, and Sections 31 and 32 Township 46 North, Range 12 West.

This corner is being re-established as part of the Luce County Remonumentation Program.

Found no evidence of the original corner or subsequent restoration. Re-established the corner by single proportionate measurement using 1/4 corner 3/34, 2 1/2 miles to the East and the Township corner 1 mile to the West. Distance East is 13,186.40 feet (GLO is 13,200 feet) Distance West is 5155.88 feet (GLO is 5161.2 feet).

C. Description of monument for corner and accessories established to perpetuate locating the position of the corner:

(C-1) Section corner common to Sections 5 and 6 Township 45 North, Range 12 West, and Sections 31 and 32 Township 46 North, Range 12 West.

Corner is a 1/2" x 48" re-rod with a stamped aluminum Luce County Remonumentation Corner cap.

Witnesses:

Tamarack 7"	N12°E	25.69 feet
Black Spruce 6"	N60°E	49.31 feet
White Pine 6"	S35°W	38.01 feet
Southerly Bow of twin	N29°W	15.28 feet
White Pine 8"		



Bearings are compass bearings, corrected for declination (6° W), all distances are to a nail and tag in the side of the witness object unless otherwise noted.

Signed by *William L. Karr*

William L. Karr, P.S.

Surveyor's Michigan License No. 27450

Date 12/01/00