

**LAND CORNER RECORDATION CERTIFICATE**  
**Filing Requirement of Act 74, Mich. P.A. 1970**  
**Luce County Remonumentation Corner**

**FEB 23 2001**

For corners in

Luce County

Located in:

Corner Code #

1. Public Land Survey

T45N R12W

E-1

Same

T46N R12W

E-13

Corner

2. Property Controlling  
in Section

S

T

R

3. Miscellaneous  
Property in Sec.

S

T

R

4. Lot No. , Recorded Plat

5. Private Claims

**SECTION**

Luce County  
REGISTER OF DEEDS  
Recorded

*Lib 3 Page 947*


02-12-2001 09:43:21

*Kathy S. Mahar*  
Kathy S. Mahar, Register  
REGISTER OF DEEDS

**Register of Deeds Stamp & File Number**

I, William L. Karr, in a field survey on August 14, 2000, do hereby state that under requirements of P.A. 74, Michigan P.A. of 1970, the corner points mentioned in lines 1 and 2 above were in conformance with regulations and rules therefore as required in the current manual of survey instructions of the United States Department of the Interior, Bureau of Land Management or by a decree of a Court of Law and /or that the corner points mentioned in lines 3, 4 and 5 above were in conformance with the rules of the Michigan Board of Land Surveyors or by a Decree of a Court of Law; established, re-established, monumented, recovered, found as expressed below:

NOTE: Not more than 2 corners, all in the same town and range, may be recorded on this certificate.

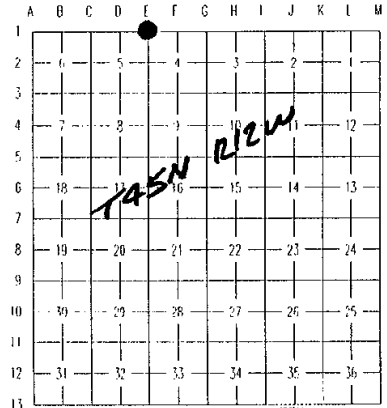

A. Description of original monument and accessories and/or subsequent restoration:

(E-1) Section corner common to Sections 4 and 5 Township 45 North, Range 12 West and Sections 32 and 33 Township 46 North, Range 12 West.

1841 W. A. Burt, D.S. set post for corner. Cedar 10 N52E 9  
Spruce 9 N24W 26

B. Description of corner evidence found and/or method applied in restoring or reestablishing corner:

(E-1) Section corner common to Sections 4 and 5 Township 45 North, Range 12 West and Sections 32 and 33 Township 46 North, Range 12 West.

This corner is being re-established as part of the Luce County Remonumentation Program.

Found no evidence of the original corner or subsequent restoration. Re-established the corner by single proportionate measurement using 1/4 corner 3/34, 1 1/2 miles to the East and the Township corner 2 miles to the West. Distance East is 7911.84 feet (GLO - 7920 feet). Distance West is 10,430.44 feet (GLO - 10,441.2 feet).

C. Description of monument for corner and accessories established to perpetuate locating the position of the corner:

(E-1) Section corner common to Sections 4 and 5 Township 45 North, Range 12 West and Sections 32 and 33 Township 46 North, Range 12 West.

Corner is a 1/2" x 48" re-rod with a stamped aluminum Luce County Remonumentation Corner cap.

Witnesses:

White Pine 19"	N67°E	27.60 feet
Red Pine 20"	S25°E	4.69 feet
Black Spruce 7"	S66°W	9.11 feet
Easterly Bow of twin	N28°W	5.83 feet
Red Pine 13"		

Bearings are compass bearings, corrected for declination (6° W),  
all distances are to a nail and tag in the side of the witness object unless otherwise noted.

Signed by *William L. Karr*  
William L. Karr, P.S.  
Surveyor's Michigan License No. 27450

Date 12/01/00

