

FEB 23 2001

LAND CORNER RECORDATION CERTIFICATE
Filing Requirement of Act 74, Mich. P.A. 1970
Luce County Remonumentation Corner

SECTION

For corners in

Luce County

Located in:

Corner Code #

- | | | | | |
|------------------------------------|---|-----------|------------|---------------|
| 1. Public Land Survey | | T45N R12W | <u>H-1</u> | Same |
| | | T46N R12W | H-13 | Corner |
| | | T | R | |
| | | T | R | |
| 2. Property Controlling in Section | S | T | R | |
| | S | T | R | |
| 3. Miscellaneous Property in Sec. | S | T | R | |
| | S | T | R | |
| 4. Lot No. | | | | Recorded Plat |
| 5. Private Claims | | | | |

LUCE COUNTY

REGISTER OF DEEDS

Recorded


Liber 3 page 950

02-12-2001 09:43:49

Kathy S. Mahar
Kathy S. Mahar, Register

REGISTER OF DEEDS

Register of Deeds Stamp & File Number

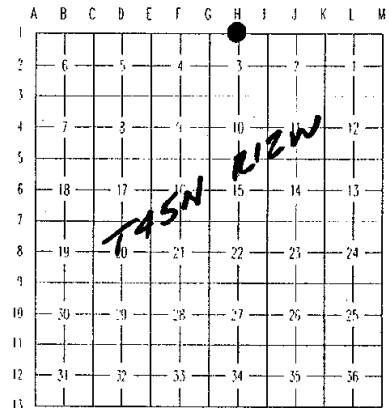

I, William L. Karr, in a field survey on July 31, 2000, do hereby state that under requirements of P.A. 74, Michigan P.A. of 1970, the corner points mentioned in lines 1 and 2 above were in conformance with regulations and rules therefore as required in the current manual of survey instructions of the United States Department of the Interior, Bureau of Land Management or by a decree of a Court of Law and /or that the corner points mentioned in lines 3, 4 and 5 above were in conformance with the rules of the Michigan Board of Land Surveyors or by a Decree of a Court of Law; established, re-established, monumented, recovered, found as expressed below:

NOTE: Not more than 2 corners, all in the same town and range, may be recorded on this certificate.


A. Description of original monument and accessories and/or subsequent restoration:

(H-1) 1/4 Corner common to Section 3 Township 45 North, Range 12 West and Section 34 Township 46 North, Range 12 West.

1841 W. A. Burt, D.S. set post for corner. Tamarack 5 N48E 11
Tamarack 5 N41W 37

1978 B. Buckler P.S. 8887 set a 1" pipe with 4" aluminum cap for corner from an original Tamarack bearing tree
(Liber 1 Page 256)

Witnesses: Cedar 6" N72E 10.7'
Cedar 14" S66W 16.2'
Cedar 6" N10W 5.1'
Cedar 6" S10E 8.6'

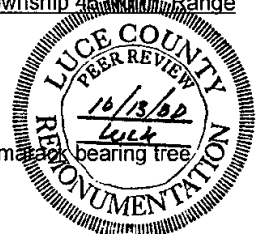

B. Description of corner evidence found and/or method applied in restoring or reestablishing corner:

(H-1) 1/4 Corner common to Section 3 Township 45 North, Range 12 West and Section 34 Township 46 North, Range 12 West.

This corner is being perpetuated as part of the Luce County Remonumentation Program.

Found 1" pipe with aluminum Michigan Department of Natural Resources cap as noted above. Accepted corner as found.

C. Description of monument for corner and accessories established to perpetuate locating the position of the corner:

(H-1) 1/4 Corner common to Section 3 Township 45 North, Range 12 West and Section 34 Township 46 North, Range 12 West.

Corner is a 1" pipe with aluminum Michigan Department of Natural Resources cap.

Witnesses:

Cedar 6"	N67°E	11.01 feet (previous)
Cedar 6"	S16°E	8.87 feet (previous)
Cedar 14"	S61°W	16.80 feet (previous)
Cedar 6"	N19°W	5.40 feet (previous)

Bearings are compass bearings, corrected for declination (6° W),
all distances are to a nail and tag in the side of the witness object unless otherwise noted.

Signed by *William L. Karr*

William L. Karr, P.S.

Surveyor's Michigan License No. 27450

Date 12/01/00

