

LAND CORNER RECORDATION CERTIFICATE
Filing Requirement of Act 74, Mich. P.A. 1970

For corners in

Luce

(County)

Located In:

Corner Code #

1. Public Land Survey

T 46N R 9W J5
T R
T R
T R
T R
S T R
S T R
S T R
S T R

2. Property Controlling
in Section

3. Miscellaneous
Property in Sec.

Register of Deeds Stamp & File Number

4. Lot No. , Recorded Plat
5. Private Claims

Mar 24 2005

I, Stephan J. Szyszkoski, in a field survey on _____, 19____ do hereby state that under requirements of P.A. 74, Michigan P.A. of 1970, the corner points mentioned in lines 1 and 2 above were in conformance with regulations and rules therefore as required in the current manual of survey instructions of the United States Department of the Interior, Bureau of Land Management or by a decree of a Court of Law and /or that the corner points mentioned in lines 3, 4 and 5 above were in conformance with the rules of the Michigan Board of Land Surveyors or by a Decree of a Court of Law; established, re-established, monumented, recovered, found as expressed below:

NOTE: Not more than 2 corners, all in the same town and range, may be recorded on this certificate.

	A	B	C	D	E	F	G	H	I	J	K	L	M
1													
2		6		5		4		3		2		1	
3													
4		7		8		9		10		11		12	
5													
6		18		17		16		15		14		13	
7													
8		19		20		21		22		23		24	
9													
10		30		29		28		27		26		25	
11													
12		31		32		33		34		35		36	
13													

A. Description of original monument and accessories and/or subsequent restoration:

(J5) Quarter corner common to Sections 11 and 14. 1850 - Established by Harvey Mellen, Deputy Surveyor: West "Corrected between Sections 11 & 14 ... 40.28 Set post qr. Section corner. Tamarac 5 S45E 15, Tamarac 7 S81W 31 ... 80.56 Set post corner of Sections 10, 11, 14, 15." 1972 - Reestablished by Billy D. Buckler RLS: Corner reestablished midway and on line bet. two Sec. Cors. Found no evidence of original corner. Set 1" pipe with 4" aluminum cap. 7" B.Spruce S89E 33.9', 9" B.Spruce S41E 19.3'.

B. Description of corner evidence found and/or method applied in restoring or reestablishing corner:


(J5) Recovered the 1972 monument in good condition and at record bearing from the 1972 B.Spruce S89E N8T, in good condition with 1972 blaze still open. The second 1972 N8T was not recovered. Found the monument to be 0.95' North and 0.41' West of the proportionate position described in the 1972 record and accepted same as a careful and faithful reestablishment of the position of the original corner.

C. Description of monument for corner and accessories established to perpetuate locating the position of the corner:

(J5) Found 1" I.pipe with 4" alum. MDNR cap. Set measuring nails in:

8" B.Spruce S83E 34.15' old blaze *
7" J.Pine N75E 50.3' mrkd "1/4S N8T"
5" B.Spruce S67E 28.75' do
4" B.Spruce S32W 5.85' do

Bearings are magnetic. Distances are to nail with tag. * denotes 1972 N8T

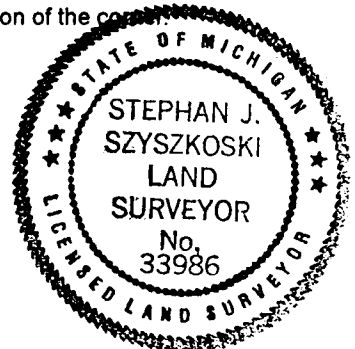

Signed by Stephan J. Szyszkoski
Surveyor's Michigan License No. 33986

Date 6/22/05