

FEB 23 2001

LAND CORNER RECORDATION CERTIFICATE
Filing Requirement of Act 74, Mich. P.A. 1970
Luce County Remonumentation Corner

SECTION

For corners in

Luce County

Located in:

Corner Code #

- | | | | | | |
|-------------------------|---|------|------|------|-----------------|
| 1. Public Land Survey | | T45N | R12W | E-1 | Same |
| | | T46N | R12W | F-13 | Corner |
| | | T | R | | |
| | | T | R | | |
| 2. Property Controlling | S | T | R | | |
| in Section | S | T | R | | |
| 3. Miscellaneous | S | T | R | | |
| Property in Sec. | S | T | R | | |
| 4. Lot No. | | | | | , Recorded Plat |
| 5. Private Claims | | | | | |

LUCE COUNTY

REGISTER OF DEEDS

Recorded


Lib 3 Page 948

02-12-2001 09:43:31

Kathy S. Mahar, Register

REGISTER OF DEEDS

Register of Deeds Stamp & File Number

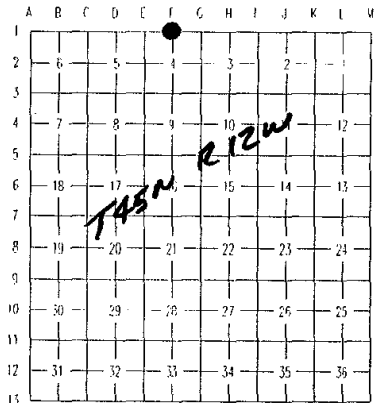

I, William L. Karr, in a field survey on August 11, 2000, do hereby state that under requirements of P.A. 74, Michigan P.A. of 1970, the corner points mentioned in lines 1 and 2 above were in conformance with regulations and rules therefore as required in the current manual of survey instructions of the United States Department of the Interior, Bureau of Land Management or by a decree of a Court of Law and/or that the corner points mentioned in lines 3, 4 and 5 above were in conformance with the rules of the Michigan Board of Land Surveyors or by a Decree of a Court of Law; established, re-established, monumented, recovered, found as expressed below:

NOTE: Not more than 2 corners, all in the same town and range, may be recorded on this certificate.

A. Description of original monument and accessories and/or subsequent restoration:

(F-1) 1/4 Corner common to Section 4 Township 45 North, Range 12 West and Section 33 Township 46 North, Range 12 West.

1841 W. A. Burt, D.S. set post for corner. Spruce 8 N19E 33
Tamarack 5 N37W 29



B. Description of corner evidence found and/or method applied in restoring or reestablishing corner:

(F-1) 1/4 Corner common to Section 4 Township 45 North, Range 12 West and Section 33 Township 46 North, Range 12 West.

This corner is being re-established as part of the Luce County Remonumentation Program.

Found no evidence of the original corner or subsequent restoration. Re-established the corner by single proportionate measurement using 1/4 corner 3/34, 1 mile to the East and the Township corner 2 1/2 miles to the West. Distance East is 5274.56 feet (GLO - 5280 feet). Distance West is 13, 067.72 feet (GLO - 13,081.2 feet).

C. Description of monument for corner and accessories established to perpetuate locating the position of the corner:

(F-1) 1/4 Corner common to Section 4 Township 45 North, Range 12 West and Section 33 Township 46 North, Range 12 West.

Corner is a 1/2" x 48" re-rod with a stamped aluminum Luce County Remonumentation Corner cap.

Witnesses:

White Birch 5"	N46°E	19.05 feet
Red Maple 7"	S26°E	12.89 feet
Red Maple 7"	S68°W	22.33 feet
Cedar 12"	N03°W	24.62 feet

Bearings are compass bearings, corrected for declination (6° W),
all distances are to a nail and tag in the side of the witness object unless otherwise noted.



Signed by William L. Karr

Date 12/01/00

Surveyor's Michigan License No. 27450