

SURVEY &
REMONUMENTATION

FEB 25 1999

SECTION

LAND CORNER RECORDATION CERTIFICATE
Filing Requirement of Act 74, Mich. P.A. 1970

FILED

For corners in

LIVINGSTON
(County)

Located in:

Corner Code #

T1N R4E

E4N R5E

1-08

T D

T D

1. Public Land Survey

2. Property Controlling
in Section

3. Miscellaneous
Property in Sec.

4. Lot No. , Recorded Plat

5. Private Claims

1998 OCT 14 P 2:11

NANCY HAVILAND
REGISTER OF DEEDS
LIVINGSTON COUNTY, MI.
48843

LSC 905M

Register of Deeds Stamp & File Number

I, JACK K. SMITH, in a field survey on OCTOBER 2, 1998 do hereby state that under requirements of D.A. 74, Michigan P.A. of 1970, the corner points mentioned in lines 1 and 2 above were in conformance with regulations and rules therefore as required in the current manual of survey instructions of the United States Department of the Interior, Bureau of Land Management or by a decree of a Court of law and/or that the corner points mentioned in lines 3, 4 and 5 above were in conformance with the rules of the Michigan Board of Land Surveyors or by a Decree of a Court of law; established, re-established, monumented, recovered, found as expressed below:

NOTE: Not more than 2 corners, all in the same town and range, may be recorded on this certificate.

| | A | B | C | D | E | F | G | H | I | J | K | L | M |
|----|----|---|----|---|----|---|----|---|----|---|----|---|----|
| 1 | | | | | | | | | | | | | |
| 2 | 6 | | 5 | | 4 | | 3 | | 2 | | 1 | | |
| 3 | | | | | | | | | | | | | |
| 4 | 7 | | 6 | | 5 | | 4 | | 3 | | 2 | | 1 |
| 5 | | | | | | | | | | | | | |
| 6 | 10 | | 9 | | 8 | | 7 | | 6 | | 5 | | 4 |
| 7 | | | | | | | | | | | | | |
| 8 | 19 | | 18 | | 17 | | 16 | | 15 | | 14 | | 13 |
| 9 | | | | | | | | | | | | | |
| 10 | 30 | | 29 | | 28 | | 27 | | 26 | | 25 | | 24 |
| 11 | | | | | | | | | | | | | |
| 12 | 31 | | 32 | | 33 | | 34 | | 35 | | 36 | | 37 |
| 13 | | | | | | | | | | | | | |

A. Description of original monument and accessories and/or subsequent restoration:

GLO 1815 WAMPLER SET POST
BLACK OAK 12 S78E 92 (60.7')
WHITE OAK 11 N42W 115 (75.9')

B. Description of corner evidence found and/or method applied in restoring or reestablishing corner:

FOUND A 1/2" IRON WITH HERBERT MUNZEL CAP AT THE INTERSECTION OF CENTER LINES OF DEPOT STREET AND HOWELL STREETS (GRAVEL). A SECOND IRON IS SOUTHEASTERLY 43.71 FEET AND HAS BEEN RECORDED AS 108 PREVIOUSLY. THE LOCATION FOR 108 IS BASED ON RECORDED RELATIONSHIPS TO THE STREETS AND PLAT OF THE VILLAGE OF PINCKNEY.

C. Description of monument for corner and accessories established to perpetuate locating the position of the corner:


I-08 EAST 1/4 CORNER SECTION 22 / WEST 1/4 CORNER SECTION 23, T1N, R4E, PUTNAM TOWNSHIP, LIVINGSTON COUNTY, MICHIGAN:

RESET FOUND 1/2" REROD WITH 1 1/4" X 36" BREAK AWAY STEEL PIPE WITH LIVINGSTON COUNTY REMONUMENTATION BRASS CAP WITH SURVEYOR #35999 @ 1/2 FOOT BELOW THE SURFACE OF GRAVEL.

N46°E 2" GALVANIZED STEEL FENCE CORNER POST 47.52'
S28°W NAIL WITH LIVINGSTON COUNTY REMON TAG IN NORTH SIDE UTIL. POLE 64.34'
N40°W NAIL WITH LIVINGSTON COUNTY REMON TAG IN SOUTH SIDE 10" DBL. OAK 103.29'
N10°W NAIL WITH LIVINGSTON COUNTY REMON TAG IN EAST SIDE UTIL. POLE 110.82'
S37°E 1/2" REROD USED PREVIOUSLY AS I-08 43.71'

Signed by [Signature] Date 10-03-1998

Surveyor's Michigan License No. 35999

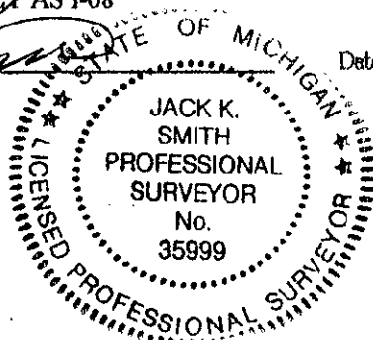

FORM APPROVED BY MICHIGAN STATE BOARD OF PROFESSIONAL SURVEYORS, J.
REVISED MAY 14, 1975 REVISED JAN. 1983
REVISED OCT. 1993

PA. 345 1889, APPROVED BY LIVINGSTON COUNTY
PEER GROUP ON 9-30-98 CO. FILED VED