

SURVEY & REMONUMENTATION

FEB 26 2001

SECTION

LAND CORNER RECORDATION CERTIFICATE Filing Requirement of Act 74, Mich. P.A. 1970

FILED

For corners in

2000 SEP 28 A 9:18

NANCY HAVILAND
REGISTER OF DEEDS
LIVINGSTON COUNTY, MI.
48843

<u>LIVINGSTON</u>	Located In:	Corner Code #
(County)		
1. Public Land Survey	T <u>1</u> N R <u>4</u> E	E-10
	T <u> </u> R <u> </u>	
	T <u> </u> R <u> </u>	
	T <u> </u> R <u> </u>	
2. Property Controlling in Section	S <u> </u> T <u> </u> R <u> </u>	
	S <u> </u> T <u> </u> R <u> </u>	
3. Miscellaneous Property in Sec.	S <u> </u> T <u> </u> R <u> </u>	
	S <u> </u> T <u> </u> R <u> </u>	

LSC #1275m

Register of Deeds Stamp & File Number

4. Lot No. , Recorded Plat
5. Private Claims

I, JACK K. SMITH, in a field survey on AUGUST 25, 2000 do hereby state that under requirements of P.A. 74, Michigan P.A. of 1970, the corner points mentioned in lines 1 and 2 above were in conformance with regulations and rules therefore as required in the current manual of survey instructions of the United States Department of the Interior, Bureau of Land Management or by a decree of a Court of Law and/or that the corner points mentioned in lines 3, 4 and 5 above were in conformance with the rules of the Michigan Board of Land Surveyors or by a Decree of a Court of Law; established, re-established, monumented, recovered, found as expressed below:

NOTE: Not more than 2 corners, all in the same town and range, may be recorded on this certificate.

A	B	C	D	E	F	G	H	I	J	K	L
1											
2	6		5		4		3		2		1
3											
4	7		8		9		10		11		12
5											
6	18		17		16		15		14		13
7											
8	19		20		21		22		23		24
9											
10	30		29		28		27		26		25
11											
12	31		32		33		34		35		36
13											

A. Description of original monument and accessories and/or subsequent restoration:

GLO 1825 JOSEPH WAMPLER SET POST
WHITE OAK 13" S78°E 31.02'
WHITE OAK 30" N40°W 49.5'

B. Description of corner evidence found and/or method applied in restoring or reestablishing corner:

THE EXISTING CORNER IS A 3/8" REROD. THERE IS A TREE AND FENCE LINE RUNNING EAST AND WEST ABOUT 3 FEET SOUTH OF THE CORNER. THERE IS A TREE ROW TO THE SOUTH AND A FURROW LINE TO THE NORTH THAT LINES UP 5 FEET WESTERLY OF THE REROD.


C. Description of monument for corner and accessories established to perpetuate locating the position of the corner:

E-10 WEST 1/4 CORNER SECTION 28, T1N, R4E, PUTNAM TOWNSHIP, LIVINGSTON COUNTY, MICHIGAN:
SET 1 1/4" x 36" STEEL PIPE WITH LIVINGSTON COUNTY REMONUMENTATION BRASS CAP STAMPED SURVEYOR #35999
PLACE OF 3/8" REROD.

EAST	SPIKE AND REMON TAG ON NORTH SIDE OF 16" HICKORY	6.16'
S45°E	SPIKE AND REMON TAG ON NORTHWEST SIDE OF 18" OAK	48.00'
S40°W	SPIKE AND REMON TAG ON EAST SIDE OF 24" OAK	12.60'
WEST	SPIKE AND REMON TAG ON WEST SIDE OF 22" OAK	32.03'

Signed by 

Date 9-15-2000

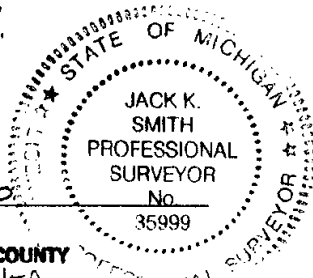

P.A. 345 1990, APPROVED BY LIVINGSTON COUNTY
PEER GROUP ON 2-2-2000 CO. REP JED

Surveyor's Michigan License No. 35999