

SURVEY & REMONUMENTATION

FEB 25 1999

SECTION

LAND CORNER RECORDATION CERTIFICATE

Filing Requirement of Act 74, Mich. P.A. 1970

FILED

For corners in

Livingston
(County)

Located In:

Corner Code //

1998 OCT 27 P 2:22

NANCY HAVILAND
REGISTER OF DEEDS
LIVINGSTON COUNTY, MI.
48843

1. Public Land Survey

T 1N R 5E

T-10

2. Property Controlling
in Section

S T R

3. Miscellaneous

S T R

Property in Sec.

S T R

LSC964M

Register of Deeds Stamp & File Number

4. Lot No. , Recorded Plat

5. Private Claims

	A	B	C	D	E	F	G	H	I	J	K	L	M
2	6	5	4	3	2	1							
3													
4	7	8	9	10	11	12							
5													
6	18	17	16	15	14	13							
7													
8	19	20	21	22	23	24							
9													
10	30	29	28	27	26	25							
11													
12	31	32	33	34	35	36							
13													

I, Bryan L. BOSS, in a field survey on Oct. 2, 19 98, do hereby certify that under requirements of P.A. 74, Michigan P.A. of 1970, the corner points mentioned in lines 1 and 2 above were in conformance with regulations and rules therefore as required in the current manual of survey instructions of the United States Department of the Interior, Bureau of Land Management or by a decree of a Court of Law and/or that the corner points mentioned in lines 3, 4 and 5 above were in conformance with the rules of the Michigan Board of Land Surveyors or by a Decree of a Court of Law; established, re-established, monumented, re-monumented, recovered, found as expressed below:

NOTE: Not more than 4 corners, all in the same town and range, may be recorded on this certificate.

A. Description of original monument and accessories and/or subsequent restoration:

Set post 1823

Black Oak 12" N 61½ E 14 links

Black Oak 9" S 80½ W 60 links

B. Description of corner evidence found and/or method applied in restoring or reestablishing corner:

Corner is lost

Corner Re-established at single proportionate distance between corner I-9 and I-11

P.A. 345 1990, APPROVED BY LIVINGSTON COUNTY

PEER GROUP ON 9-30-98, CO. REP LED

C. Description of monument for corner and accessories established to perpetuate locating the position of the corner:


Set 1½" by 36" iron pipe with Brass cap stamped "Livingston County Monumentation Corner

N 15 E 14.97 set Remon N/T Westside 5" Cedar

N 80 E 9.50 set Remon N/T Southeast side 8" Poplar

South 7.38 set Remon N/T Westside 4" Cedar

N 70 W 14.14 set Remon N/T Northside 8" Bigtooth Aspen

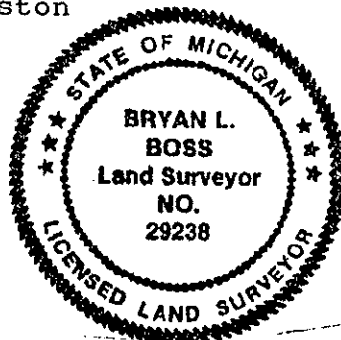

Signed by Bryan L. Boss

Date 10-15-98

Surveyor's Michigan License No. 29238