

MAR 17 2000

SECTION

LAND CORNER RECORDATION CERTIFICATE  
Filing Requirement of Act 74, Mich. P.A. 1970

For corners in  
LIVINGSTON  
(County)

Located in: HAMBURG Corner Code #

1999 NOV 22 A 11:09

NANCY HAVILAND  
REGISTER OF DEEDS  
LIVINGSTON COUNTY, MI.  
48843

1. Public Land Survey T 1N R 5E G-9  
T R  
T R  
T R
2. Property Controlling S T R  
in Section S T R
3. Miscellaneous S 21 T 1N R 5E 011 ✓  
Property in Sec. S 28 T 1N R 5E 012

LSC# 1123m

Register of Deeds Stamp and File Number

4. Lot No. , Recorded Plat
5. Private Claims

I, Bryan L. Boss, in a field survey on OCT. 28, 1999  
do hereby certify that under requirements of P.A. 74, Michigan P.A. of 1970, the corner points mentioned  
in lines 1 and 2 above were in conformance with regulations and rules therefor as required in the  
current manual of survey instructions of the United States Department of the Interior, Bureau of Land  
Management or by a decree of a Court of Law and/or that the corner points mentioned in lines 3,4 and 5  
above were in conformance with the rules of the Michigan Board of Land Surveyors or by a Decree of a  
Court of Law; established, re-established, monumented, re-monumented, recovered, found as  
expressed below.

NOTE: Not more than 4 corners, all in the same town and range, may be recorded  
on this certificate.

- A. Description of original monument and accessories and/or subsequent restoration:  
CORNER NOT SET IT IS IN ZUKEY LAKE

- B. Description of corner evidence found and/or method applied in restoring or reestablishing corner:

CORNER LOCATION ESTABLISHED FROM PREVIOUS SURVEY DATA  
BY CLAY GORDON (1934)  
CORNER ESTABLISHED AS BEING 244.50 FEET EAST OF A 3/8"  
IRON ROD ON THE WEST SHORE OF ZUKEY LAKE ALONG A  
PREVIOUSLY SURVEYED AND MONUMENTED LINE.

CORNER G-9 TO REF. PT. 1 S86°21'37"W, 244.50' (011)  
CORNER G-9 TO REF. PT. 2 S02°24'45"E, 577.97' (012)  
REF. PT. 1 TO REF. PT. 2 S26°19'00"E, 626.38'

REFERENCE POINT 1 (WEST OF CORNER) (011)  
THIS POINT IS LOCATION OF 3/8" IRON ROD FOUND ON THE  
MONUMENTED SECTION LINE BETWEEN SECTION 21 AND 28 15  
FEET MORE OR LESS WEST OF THE WEST SHORE OF ZUKEY LAKE


REFERENCE POINT 2 (SOUTH OF CORNER) (012)  
SET REMON PIPE AND CAP AT POINT 4 FEET SOUTH OF THE  
SOUTH SHORE OF ZUKEY LAKE 60 FEET MORE OR LESS EAST OF  
A WATERWAY RUNNING NORTH-SOUTH BETWEEN ZUKEY LAKE  
AND STRAWBERRY LAKE

- C. Description of monument for corner and accessories established to perpetuate locating the position of the corner:

REFERENCE POINT 1 - 011  
SET 1 1/4" X 36" PIPE WITH BRASS CAP STAMPED  
"LIVINGSTON COUNTY REMONUMENTATION  
WITNESS" OVER FOUND 3/8" IRON ROD  
N10°W 5.05' SET REMON NAIL & TAG E/S 24" OAK  
S80°W 16.29' SET REMON NAIL & TAG N/S 10" OAK  
S10°W 34.86' NE CORNER BROWN HOUSE  
N10°W 4.32' FOUND 1/2" IRON ROD  
SOUTH 33.11' NE CORNER SECOND DECK  
CORNER POST

REFERENCE POINT 2 - 012  
SET 1 1/4" X 36" IRON PIPE WITH BRASS CAP  
STAMPED "LIVINGSTON COUNTY  
REMONUMENTATION WITNESS"  
WEST 22.61' SET REMON NAIL & TAG N/S 18"  
COTTONWOOD  
SOUTH 83.76' NW COR. OF HOUSE FOUNDATION  
S45°E 22.22' SET REMON NAIL & TAG NE/S 12" ASH  
EAST 117.85' FOUND CONCRETE MONUMENT

P.A. 345 1990, APPROVED BY LIVINGSTON COUNTY  
PEER GROUP ON 9-1-99 CO. REP JED

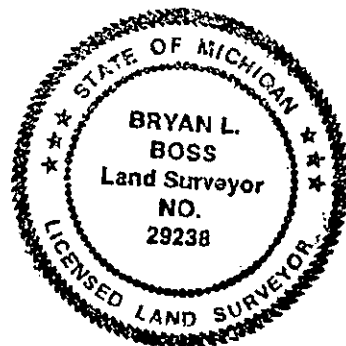

Signed by Bryan L. Boss

Date NOV. 12 1999

Surveyor's Michigan License No. 29238