

1996 NOV 25 A 9:40

**LAND CORNER RECORDATION CERTIFICATE**  
**Filing Requirement of Act 74, Mich. P.A. 1970**

NANCY HAVILAND  
 REGISTER OF DEEDS  
 LIVINGSTON COUNTY, MI.  
 48843

For Corners in GREEN OAK TWP.

LIVINGSTON  
 (COUNTY)

1. Public Land Survey Located In Corner Code #  
                                   T1N R6E                                   B-9  
                                   T\_\_\_ R\_\_\_  
                                   T\_\_\_ R\_\_\_  
                                   T\_\_\_ R\_\_\_

2. Property Controlling in Section   S\_\_\_ T\_\_\_ R\_\_\_  
   S\_\_\_ T\_\_\_ R\_\_\_

3. Miscellaneous                   S\_\_\_ T\_\_\_ R\_\_\_  
   Property in Sec.               S\_\_\_ T\_\_\_ R\_\_\_

4. Lot No. \_\_\_\_\_, Recorded Plat \_\_\_\_\_

5. Private Claims \_\_\_\_\_

L.S.C. #620m

## REGISTER OF DEEDS STAMP &amp; FILE NUMBER

	A	B	C	D	E	F	G	H	I	J	K	L	M
2	6	5	4	3	2	1							
3													
4	7	8	9	10	11	12							
5													
6	18	17	16	15	14	13							
7													
8	19	20	21	22	23	24							
9													
10	30	29	28	27	26	25							
11													
12	31	32	33	34	35	36							
13													

I, BRYAN L. BOSS in a field survey on OCTOBER 26, 1996, do hereby certify that under requirements of P.A. 74, Michigan P.A. of 1970, the corner points mentioned in lines 1 and 2 above were in conformance with regulations and rules therefore as required in the current manual of survey instructions of the United States Department of the Interior, bureau of Land Management or by a decree of a Court of Law and/or that the corner points mentioned in lines 3, 4 and 5 above were in conformance with the rules of the Michigan Board of Land Surveyors or by a Decree of a Court of Law, established, re-established, monumented, re-monumented, recovered, found as expressed below:

NOTE: Not more than 4 corners, all in the same town and range, may be recorded on this certificate.

## A. Description of original monument and accessories and/or subsequent restoration:

½ MILE POST SET IN 1816 BY ALEX HOLMES DEPUTY SURVEYOR  
 WHITE OAK 12" N 56° W 16  
 RED OAK 16" S 12° E 29


## B. Description of corner evidence found and/or applied in restoring or reestablishing corner:

FOUND ½ IRON ROD 0.2 TENTHS BELOW GRAVEL SURFACE AT CENTERLINE OF  
 SPICER ROAD AND CENTERLINE OF MUSCH ROAD.

## C. Description of monument for corner and accessories established to perpetuate location the position of the corner:

SET 1 ¼ X 30" PIPE WITH A 6" BREAK OFF AND BRASS CAP MARKED "LIVINGSTON COUNTY  
 MONUMENT CORNER."

N 30° E NAIL & TAG WEST SIDE 24" HICKORY 77.17'  
 S 50° E NAIL & TAG NORTH SIDE 10" HICKORY 41.84'  
 S 45° W NAIL & TAG NORTHWEST SIDE 8" HICKORY 34.46'  
 N 30° W NAIL & TAG NORTHEAST SIDE 6" OAK 58.49'

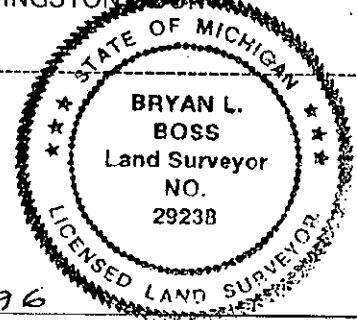

Signed by Bryan L. Boss  
 Surveyor's Michigan License No. 29238

Date 11-15-1996

FORM APPROVED BY MICHIGAN STATE BOARD OF LAND SURVEYORS, JAN. 28, 1971

REVISED MAY 14, 1975  
 REVISED JAN., 1983

## SUMMARY

B-9

North ¼ Corner, Section 30, T1N-R6E, Green Oak Township, Livingston County, Michigan.

Found ½" Iron rod below gravel surface at centerline Musch Road and centerline of Spicer Road. Clean sweep of area and found no evidence of another corner. This intersection is open to G.P.S. witnesses by Donald Ross in 1976-77, Boss Engineering in 1976-77-80-84-88-92, and Charles Garlock in 1993; all agree as to the location of ½" Iron rod being the South ¼ corner of Section 19 or North ¼ corner, Section 30. The Distance sheet on Page 6, this dossier also finds agreement on measurements by Ross, Garlock, and Boss Engineering.

Fence line occupation southerly.

We find the ½" Iron rod found on March 26, 1996, to be at the same location described by Munsell & Garlock on April 8, 1970.

We recommend acceptance as found.

