

SURVEY &  
REMONUMENTATION

APR 28 1995

LAND CORNER RECORDATION CERTIFICATE

COMMISSION

Filing Requirement of Act 74, Mich. P.A. 1970

FILED

Nov 16 11 02 AM '94

NANCY HAVILAND  
REGISTER OF DEEDS  
LIVINGSTON COUNTY, MI  
48843

L.S.C.#307m

Register of Deeds Stamp & File Number

For corners in

Livingston

(County)

Located In:

Corner Code  $\neq$

Public Land Survey

T 1N R 6E

H-11

T R

T R

T R

T R

Property Controlling

S T R

in Section

S T R

Miscellaneous

S T R

Property in Sec.

S T R

Lot No. , Recorded Plat

Private Claims

H.L. O'Donnell, in a field survey on August 30, 1994

to hereby certify that under requirements of P.A. 74, Michigan P.A. of 1970, the corner points mentioned in lines 1 and 2 above were in conformance with regulations and rules therefore as required in the current manual of survey instructions of the United States Department of the Interior, Bureau of Land Management or by a decree of a Court of Law and/or that the corner points mentioned in lines 3, 4 and 5 above were in conformance with the rules of the Michigan Board of Land Surveyors or by a Decree of a Court of Law; established, re-established, monumented, re-monumented, recovered, found as expressed below:

NOTE: Not more than 4 corners, all in the same town and range, may be recorded on this certificate.

Description of original monument and accessories and/or subsequent restoration:

GLO notes dated: 12-14-1815

GLO witnesses: W. Oak 24 in. dia. bears N38 1/2 E 278 lks

Corner Summary on reverse side.

	A	B	C	D	E	F	G	H	I	J	K	L	M
2	6		5		4		3		2		1		
3													
4	7		8		9		10		11		12		
5													
6	18		17		16		15		14		13		
7													
8	19		20		21		22		23		24		
9													
10	30		29		28		27		26		25		
11													
12	31		32		33		34		35		36		
13													

Description of corner evidence found and/or method applied in restoring or reestablishing corner:

Found 1/2" rod with obliterated cap

Center of black top North 9.26'

Center of conc. and rebar mound North 50.6'

Nail in S. face D.E. pole N55°E 66.60'

Nail in S. face D.E. pole N80°W 160.61'

Nail in SW face MBT pole S40°E 31.63'

Nail in N. face MBT pole S80°W 105.87'

Description of monument for corner and accessories established to perpetuate locating the position of the corner:

H-11, N 1/4 cor. Sec. 34, T1N, R6E, Green Oak Township

Set 1 1/2" x 36" iron pipe with L.C.M. brass cap PS #28149 in mon. box


Set flasher S. face P. pole N55°E 66.60'

Set flasher S. face P. pole N80°W 160.61'

Set flasher SW face P. pole S40°E 31.63'

Set flasher N. face P. pole S80°W 105.87'

Approved by Livingston County Monumentation Peer Group August

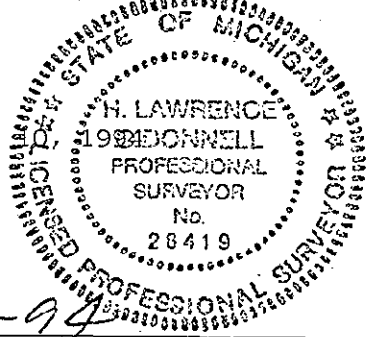

Signed by

Date

Surveyor's Michigan License No. 28149

FORM APPROVED BY MICHIGAN STATE BOARD OF LAND SURVEYORS, JAN. 28, 1971  
REVISED MAY 14, 1975  
REVISED JAN., 1983

P.A. 345 1990, APPROVED BY LIVINGSTON COUNTY

PEER GROUP ON Aug 94 CO. REP MBL

CORNER SUMMARY

H-11, N 1/4 corner, Section 34  
Green Oak Township, Livingston County

The oldest known witness is by G.H. Dunning in 1923. In 1947 Munsell stated that he could not find said corner and that he set the corner at the intersection of the N-S fence line and at the south line of the Highway. The corner was later witnessed by Cole in 1952, by Munsell in 1957, by Tredennich in 1971, 1973 & 1974, by Boss in 1977 & 1978, by the Michigan Highway Department in 1983 and by Jekabson in 1992.

Atwell-Hicks, Inc. found a 1/2" iron rod in 1994 located 9.26' south of the road centerline. The witness summary shows a good progression of witnesses. No other irons were found after a search of the area.

I recommend that this found iron rod be accepted as the N 1/4 corner of Section 34 of Green Oak Township.

  
H. Lawrence O'Donnell