

SURVEY & REMONUMENTATION

MAR 17 2000

FILED

SECTION

LAND CORNER RECORDATION CERTIFICATE

Filing Requirement of Act 74, Mich. P.A. 1970

For corners in

LIVINGSTON

(County)

Located in: GREEN OAK Corner Code #

1. Public Land Survey T 1N R 6E G-8
T R
T R
T R
2. Property Controlling S T R
In Section S T R
3. Miscellaneous S 21 T 1N R 6E 005 ✓
Property in Sec. S 21 T 1N R 6E 006

LSC# 1149m

Register of Deeds Stamp and File Number

4. Lot No. , Recorded Plat
5. Private Claims

I, Bryan L. Boss, in a field survey on NOV. 10, 1999

do hereby certify that under requirements of P.A. 74, Michigan P.A. of 1970, the corner points mentioned in lines 1 and 2 above were in conformance with regulations and rules therefor as required in the current manual of survey instructions of the United States Department of the Interior, Bureau of Land Management or by a decree of a Court of Law and/or that the corner points mentioned in lines 3, 4 and 5 above were in conformance with the rules of the Michigan Board of Land Surveyors or by a Decree of a Court of Law; established, re-established, monumented, re-monumented, recovered, found as expressed below.

NOTE: Not more than 4 corners, all in the same town and range, may be recorded on this certificate.

A. Description of original monument and accessories and/or subsequent restoration:

NOTHING WAS SET ORIGINALLY DUE BEING IN LAKE

B. Description of corner evidence found and/or method applied in restoring or reestablishing corner:

This location was determined from an analysis of deeds in the area and their relationship with the nearby plat of "PEACH'S SUBDIVISION NO. 2". Deeds show that there was a 50 foot wide parcel adjacent to the south line of the subdivision. A retracement survey of the subdivision and the adjoining property was conducted. The Corner was placed on the straight line between Corners G-7 and G-9 at the intersection of a line from the center of Section and a line 50 feet south of the South line of "PEACH'S SUBDIVISION NO. 2". This point is in Silver Lake. Reference Point No. 1 was placed on the East-West 1/4 line of Section 21, S 86°50'12" W, 54.39' from G-8 on the shore of Silver Lake. Reference Point 2 was placed on the line between Section 21 and 22 on the shore of Silver Lake S 03°31'44" E, 283.18' from corner G-8. A line between Reference point 1 and Reference point 2 has the bearing of S 14°23'35" E, and distance of (005-006) 288.70'

C. Description of monument for corner and accessories established to perpetuate locating the position of the corner:

REFERENCE POINT 1 (005)

SET 1 1/4"X 3/8" PIPE WITH BRASS CAP STAMPED
'LIVINGSTON COUNTY REMONUMENTATION
WITNESS"
N89°W 12.22' SET REMON NAIL & TAG N/S 30" ELM
EAST 0.86' SET REMON NAIL & TAG IN TOP OF
WOOD RETAINING WALL
NORTH 51.18' CENTER 3"X3" STEEL FENCE POST
S05°W 27.39' CENTER 4" STEEL WELL CASING


REFERENCE POINT 2 (006)

SET 1 1/4"X 3/8" PIPE WITH BRASS CAP STAMPED
'LIVINGSTON COUNTY REMONUMENTATION
WITNESS"
N30°E 1.90' CENTER IRON EYE BOLT WITH RING
IN CONCRETE RETAINING WALL
WEST 48.58' NORTHEAST HOUSE CORNER
S70°W 53.19' CORNER OF STONE CHIMNEY
S30°E 60.27' SET REMON NAIL & TAG E/S 16" M/PLE

	A	B	C	D	E	F	G	H	I	J	K	L	M
2	6		5		4		3		2		1		
3													
4	7		8		9		10		11		12		
5													
6	18		17		16		15		14		13		
7													
8	19		20		21		22		23		24		
9													
10	30		29		28		27		26		25		
11													
12	31		32		33		34		35		36		
13													

P.A. 345 1990, APPROVED BY LIVINGSTON COUNTY

PEER GROUP ON 10-8-99, CO. REP JED

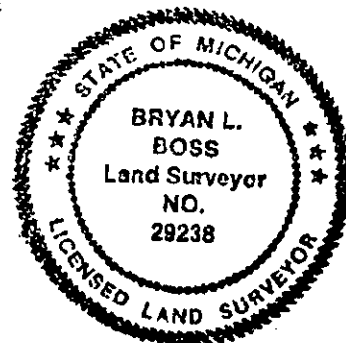

Signed by Bryan L. Boss

Date NOV. 11, 1999

Surveyor's Michigan License No. 29238