

LAND CORNER RECORDATION CERTIFICATE
Filing Requirement of Act 74, Mich. P.A. 1970

For corners in

Livingston
(County)

Located In:

Corner Code #

1. Public Land Survey

T 2N R 3E

L-11

T R

T R

T R

2. Property Controlling
In Section

S T R

S T R

3. Miscellaneous
Property in Sec.

S T R

S T R

4. Lot No. , Recorded Plat

5. Private Claims

DEC 27 12 22 PM '93
NANCY HAVLAND
REGISTER OF DEEDS
LIVINGSTON COUNTY, MI
48843

FILED

L.S.C. #125m

Register of Deeds Stamp & File Number

I, Darrell D. Hughes a field surveyor on December 17, 19 93,
do hereby certify that under requirements of P.A. 74, Michigan P.A. of 1970, the corner points mentioned
in lines 1 and 2 above were in conformance with regulations and rules therefore as required in the
current manual of survey instructions of the United States Department of the Interior, Bureau of Land
Management or by a decree of a Court of Law and/or that the corner points mentioned in lines 3, 4 and 5
above were in conformance with the rules of the Michigan Board of Land Surveyors or by a Decree of a
Court of Law; established, re-established, monumented, re-monumented, recovered, found as
expressed below:

NOTE: Not more than 4 corners, all in the same town and range, may be recorded
on this certificate.

A. Description of original monument and accessories and/or subsequent restoration:

GLO: 1825
White Oak 30" N21½E 10 lks.
White Oak 6" S21W 4 lks.

	A	B	C	D	E	F	G	H	I	J	K	L	M
2	6		5		4		3		2				
3													
4	7		8		9		10		11		12		
5													
6	18		17		16		15		14		13		
7													
8	19		20		21		22		23		24		
9													
10	30		29		28		27		26		25		
11													
12	31		32		33		34		35		36		
13													

SURVEY
REMONUMENTATION

1993

COMMISSION

*Additional historical information on back of sheet:

B. Description of corner evidence found and/or method applied in restoring or reestablishing corner:

Found 3" pipe, 3 ft. above grade.

C. Description of monument for corner and accessories established to perpetuate locating the position of the corner:


L-11, T2N, R3E, IOSCO, replaced existing corner with 1-1/4" X 36" iron
pipe, affixed with 2" dia. brass cap, stamped "Livingston Co.
Monumentation Corner, P.S. 19834, and is accepted as a careful and
faithful reestablishment of the position of the original corner.
211 DEG. 8.95' SET NAIL/TAG E/S 22" ASH.
053 DEG. 14.35' SET NAIL/TAG NW/S 12" SASAFRAS.
318 DEG. 15.19' SET NAIL/TAG NE/S 10" MAPLE.
002 DEG. 44.12' SET NAIL/TAG W/S 18" MAPLE.

Signed by [Signature]
Surveyor's Michigan License No. 19834

Date December 27, 1993

Approved by Liv. Co. Peer Group: December 11, 1993

FORM APPROVED BY MICHIGAN STATE BOARD OF LAND SURVEYORS, JAN. 28, 1971
REVISED MAY 14, 1975
REVISED JAN., 1983

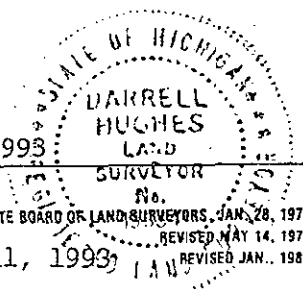

IOSCO TOWNSHIP, T2N, R3E

L-11, NORTH 1/4 CORNER SECTION 36

FIELD 10-27-1993 D.D.HUGHES AND ASSOCIATES, FOWLERVILLE

Found 3" pipe, 3' above grade, fd. 2 witness ties, nails grown over.

1825, corner first set by Sylvester Sibley, Deputy U.S. Surveyor.
39.93 chains for 1/2 mile. (2635.38')

1861, E.N.Fairchilds, County Surveyor, divided Section 36.

1918, Grant Dunning shows corner to be 40 chains West of NE cor.

1936, Clay Gordon shows corner 40.2 chains East of NW cor.

1976, Boss ran extensive traverse for all of Section 36 and into the
East 1/2 of Section 35. Found 3" pipe, 3' high for this corner.

1976, Boss files Act 74

Corner in thick wooded area, downed fence north and south.