

MAR 17 2000

SECTION

LAND CORNER RECORDATION CERTIFICATE
Filing Requirement of Act 74, Mich. P.A. 1970

FILED

For corners in

LIVINGSTON
(County)

Located In:

Corner Code #

1999 MAY 21 A 9:23

NANCY HAVILAND
REGISTER OF DEEDS
LIVINGSTON COUNTY, MI.
48843

L.S.C. #1020

Register of Deeds Stamp & File Number

1. Public Land Survey

T2N R4E

G-12

T R

T R

T R

2. Property Controlling
in Section

S

T R

S

T R

3. Miscellaneous
Property in Sec.

S

T R

S

T R

4. Lot No. , Recorded Plat

5. Private Claims

I, JACK K. SMITH, in a field survey on APRIL 30, 1999 do hereby state that under requirements of P.A. 74, Michigan P.A. of 1970, the corner points mentioned in lines 1 and 2 above were in conformance with regulations and rules therefore as required in the current manual of survey instructions of the United States Department of the Interior, Bureau of Land Management or by a decree of a Court of Law and/or that the corner points mentioned in lines 3, 4 and 5 above were in conformance with the rules of the Michigan Board of Land Surveyors or by a Decree of a Court of Law, established, re-established, monumented, recovered, found as expressed below:

NOTE: Not more than 2 corners, all in the same town and range, may be recorded on this certificate.

	A	B	C	D	E	F	G	H	I	J	K	L	M
1													
2	6		5		4		3		2		1		
3													
4	7		8		9		10		11		12		
5													
6	18		17		16		15		14		13		
7													
8	19		20		21		22		23		24		
9													
10	30		29		28		27		26		25		
11													
12	31		32		33		34		35		36		
13													

A. Description of original monument and accessories and/or subsequent restoration:

GLO 1825 SIBLEY SET POST
W. OAK 6 S 24 E 4.9'
W. OAK 4 N 34 1/2 W 42.24'

B. Description of corner evidence found and/or method applied in restoring or reestablishing corner:

REPLACED THE CORNER FROM PREVIOUS WITNESSES AND FOUND MONUMENTATION. THIS POSITION IS THE ONLY ONE THAT APPEARS TO HAVE BEEN USED.

C. Description of monument for corner and accessories established to perpetuate locating the position of the corner:


G-12 WEST 1/4 CORNER SECTION 34 AND EAST 1/4 CORNER SECTION 33, T2N, R4E, MARION TOWNSHIP, LIVINGSTON COUNTY, MICHIGAN:
SET 1 1/4" X 36" STEEL PIPE WITH BREAK-OFF AND LIVINGSTON COUNTY REMONUMENTATION BRASS CAP WITH SURVEYOR #35999 @ 1/2 FOOT BELOW THE SURFACE OF GRAVEL ROADWAY NEAR CENTER LINE.

EAST NAIL WITH LIVINGSTON COUNTY REMON TAG IN NORTH SIDE UTILITY POLE 63.48'
N40°W NAIL WITH LIVINGSTON COUNTY REMON TAG IN EAST SIDE DBL. 8" HICKORY 28.18'
S87°W NAIL WITH LIVINGSTON COUNTY REMON TAG IN SOUTH SIDE 9" WHITE PINE 48.47'
S40°W NAIL WITH LIVINGSTON COUNTY REMON TAG IN EAST SIDE 36" OAK 40.60'

Signed by

Date 5-8-1999

Surveyor's Michigan License No. 35999

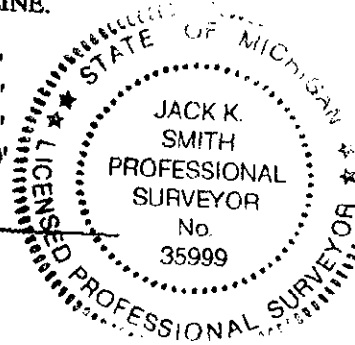

P.A. 345 1990, APPROVED BY LIVINGSTON COUNTY
PEER GROUP ON 4-21-1999 CO. REP JED

FORM APPROVED BY MICHIGAN STATE BOARD OF PROFESSIONAL SURVEYORS, JAN. 21
REVISED MAY 14, 1975
REVISED JAN. 1983
REVISED OCT. 1993