

FILED

9

LAND CORNER RECORDATION CERTIFICATE

MAY 9 11 03 AM '95

Filing Requirement of Act 74, Mich. P.A. 1970

NANCY HAYLAND
REGISTER OF DEEDS
LIVINGSTON COUNTY, MI
48843

For corners in

Livingston

(County)

Located in:

Corner Code M-5

1. Public Land Survey

T 2N R 4E

M-5

T _____ R _____

T _____ R _____

T _____ R _____

2. Property Controlling
in Section

S _____ T _____ R _____

S _____ T _____ R _____

3. Miscellaneous
Property in Sec.

S _____ T _____ R _____

S _____ T _____ R _____

C.L.S. #398m

Register of Deeds Stamp & File Number

4. Lot No. _____, Recorded Plat _____

5. Private Claims _____

	A	B	C	D	E	F	G	H	I	J	K	L	M
2	6	5	4	3	2	1							
3													
4	7	8	9	10	11	12							
5													
6	18	17	16	15	14	13							
7													
8	19	20	21	22	23	24							
9													
10	30	29	28	27	26	25							
11													
12	31	32	33	34	35	36							
13													

I, Charles E Garlock, in a field survey on April 28, 19 95,
do hereby certify that under requirements of P.A. 74, Michigan P.A. of 1970, the corner points mentioned
in lines 1 and 2 above were in conformance with regulations and rules therefore as required in the
current manual of survey instructions of the United States Department of the Interior, Bureau of Land
Management or by a decree of a Court of Law and/or that the corner points mentioned in lines 3, 4 and 5
above were in conformance with the rules of the Michigan Board of Land Surveyors or by a Decree of a
Court of Law; established, re-established, monumented, re-monumented, recovered, found as
expressed below:

NOTE: Not more than 4 corners, all in the same town and range, may be recorded
on this certificate.

A. Description of original monument and accessories and/or subsequent restoration:

GLO survey dated: April 15, 1825 by S Sibley, DS.

GLO witnesses: W013-S28½W-37 lks

W014-N57½W-56 lks

Additional historical data on rear of sheet

B. Description of corner evidence found and/or method applied in restoring or reestablishing corner:

Found 1/2" I. Rod 17'± East of c/l of Fisk Rd.

C. Description of monument for corner and accessories established to perpetuate locating the position of the corner:

M-5: Northeast corner Section 13, T2N-R4E, Marion Twp. Liv. Co. MI; reset 1/2" I. Rod
with 1 1/4" X 36" Iron Pipe with Liv. Co. Remon brass cap on top at -0.2' on back-
slope of Fisk Rd.

N85W-77.51'-sp & tag S/s U Pole


N15E-14.00'-sp & tag W/s 12" Hickory

N10E-42.28'-sp & tag W/s 15" Hickory

N05E-77.46'-sp & tag W/s U. Pole

West-17'±-c/l Fisk Road

North-363.33'-NW corner Section 18 T2N-R5E

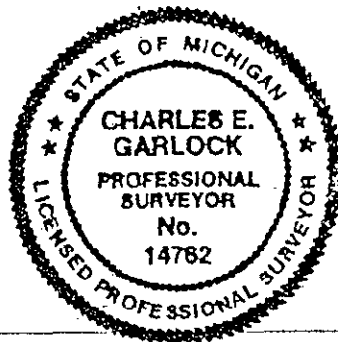

Signed by Charles E Garlock Date April 29, 1995

Surveyor's Michigan License No. 14762

PA 345 1982, APPROVED BY LIVINGSTON COUNTY
FEB 28 1995 3-1-95

FORM APPROVED BY MICHIGAN STATE BOARD OF LAND SURVEYORS, JAN. 28, 1971
REVISED MAY 14, 1975
REVISED JAN. 1983

CORNER SUMMARY

ACT 62 COS. SEC. 12, T2N-R4E, MARION TWP. LIV. CO., MI


GLO SURVEY DATED APRIL 15, 1825 BY S SIBLEY AND NONE OF THE GLO WITNESSES REMAIN.

NO KNOWN ACTIVITY UNTIL 1976 WHEN BOSS SET A 1/2" I. ROD. SINCE THEN BENTON, BOSS, DESINE AND MYSELF HAVE BEEN TO THE 1/2" I. ROD, WITNESSED IT AND THOSE THAT HAVE REMAINED CHECK PRESENTLY. THE EXISTING 1/2" I. ROD IS LOCATED ABOUT 17 FT. EAST OF THE CENTERLINE OF FISK RD. (GRAVEL) ON A BACK SLOPE AND ON THE TOWNSHIP LINE. REMAINS OF AN OCCUPATION LINE LIE TO THE WEST AND MANY YEARS AGO THE CENTERLINE OF WRIGHT ROAD WAS LOCATED TO THE WEST, BUT WAS RELOCATED NORTH TO AVOID A SINK HOLE. THE GLO DISTANCE NORTH TO THE GENOA CORNER IS 362.34 FT. AND IT MEASURES 363.33 FT. MEASURES NORTH TO THE MARION 1/4 CORNER ARE: 2657.40 BY BENTON AND MYSELF AND 2657.41 BY BOSS. SOUTH TO THE MARION 1/4 CORNER: 2636.71 BY DESINE AND MYSELF. WEST TO THE 1/4 CORNER: 2519.14 BY BOSS AND 2519.11 BY DESINE. FOUND ONE ACT 74 RECORDED AND THREE ACT 132'S. A GPS OBSERVATION IS OPEN ONLY IN QUADRANTS III & IV.



CHARLES E GARLOCK
PS 14762

M5MAR95

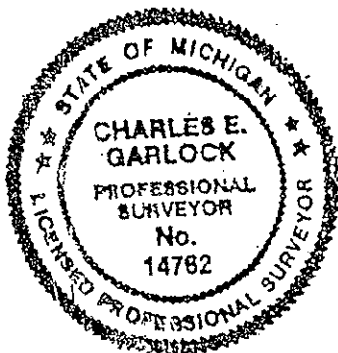

2N-4E 14-5
L