		· · · · · · · · · · · · · · · · · · ·					
	LAND CORN	IER RECORDATION CERT	TIFICATE				
for corners in	Filing Requi	irement of Act 74, Mich. I	P.A. 1970	AII B	SEP	- Control of the Cont	
Livingston (County)	Located In:	Corner Code ##		NANC ECIST		פשני	
. Public Land Survey	T2N R 4E		4888 88	Y HAV ER OF	3 28	FILED	
	T R			UNTY.	PH	O,	
. Property Controlling	S T R			X S	1 5.		
in Section Miscellaneous	S T R S T R		L.S.C.# 236m Register of Deeds	Stamp &	File Nu	ımber	
Property in Sec.	S R		1				_
. Lot No , . Private Claims	, Recorded Plat		A B C D	E F G	н і	JKL	
			2 6 5 5 -	+++	- 3	-2	-
Charles E Garloc	ck :- sta	igust 18 - 19 94	4 7 8-	9-	-10	-1 1	12-
	≠is in a neid survev on — ru	14 4 4 4 4 4 4 4 4 4 4 4 4 4 4 4 4 4 4	51 F (1 1 1	1 1	1 1 '	1

Dourt of Law; established, re-established, monumented, re-monumented, recovered, found as expressed below: NOTE: Not more than 4 corners, all in the same town and range, may be recorded on this certificate.

to hereby certify that under requirements of P.A. 74, Michigan P.A. of 1970, the corner points mentioned n lines 1 and 2 above were in conformance with regulations and rules therefore as required in the Durrent manual of survey instructions of the United States Department of the Interior, Bureau of Land -Management or by a decree of a Court of Law and/or that the corner points mentioned in lines 3, 4 and 5 ⇒bove were in conformance with the rules of the Michigan Board of Land Surveyors or by a Decree of a

A. Description of original monument and accessories and/or subsequent restoration:

GLO survey date: April 15, 1825 by S Sibley GLO witnessess: WO20-S66W-0.29 ch

B07-N30%W-0.96 ch

See additional data on rear of sheet 3. Description of corner evidence found and/or method applied in restoring or reestablishing corner: Found 1/2" I. rod set by PL Benton next to OLD corner post with fence lines to North, South and West.

SURVEY & REMONUMENTATION

SEP 2 6 1994

COMMISSION

	M-8: East 1/4 cor. Sec. 24 T2N-R4E,	ories established to perpetuate locating the position of the corner: E, Marion Twp. Liv. Co. MI, set 1 1/4" X 36" I. Pop at +0.5' in the ctr. of the OLD post hole rung OF M/C// CHARLES E. GARLOCK PROFESSIONAL SURVEYOR No.	ipe
g	ned by Chalac Harb	Date August 19, 1994	

14762 urveyor's Michigan License No. .

PA. 345 1980, APPROVED BY LIVINGSTON COUNTY


REVISED MAY 14, 1975

PEER GROUP ON 9 Akril 940. REP Machine.

REVISED JAN., 1983

GLO notes dated April 15, 1825 by S. Sibley, D.S.
Found no records of this Corner in any of the County Surveyor records in the Court House or my office. Found a 1/2" I. Rod set by PL Benton with his cap at the E 1/4 corner of Section 24 Marion Twp. and found a very old corner post with fences to the North, South and West; also at 222.21 feet to the North I found a corner post for the W 1/4 corner of Section 19 Genoa Twp. GLO jog calcs at 240.90'. Measured 2634.35' North to the NE Corner Sec.24 and 2658.78' South to the SE Corner Sec.24 from the E 1/4 cor. All known surveys by P.L. Benton, Boss Engineering and myself have used this point as the 1/4 Corner as occupied. Area is wooded on the East side of the Twp. line to the North and South and fairly wooded to the SW; only the NW is open.

Found no other irons in the area.

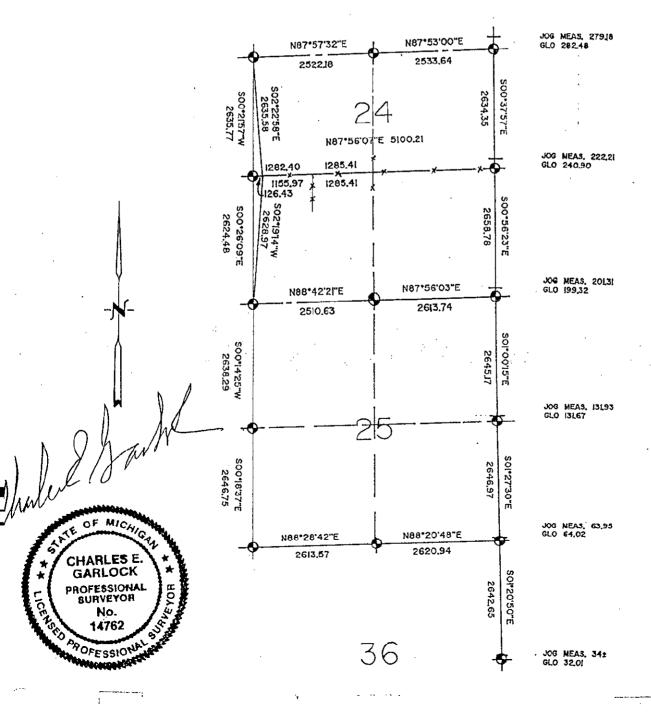

SW-ME MS

4