

FEB 25 1999

SECTION

LAND CORNER RECORDATION CERTIFICATE  
Filing Requirement of Act 74, Mich. P.A. 1970

FILED

or corners in

Livingston  
(County)

Located In:

Corner Code //

1998 OCT 22 P 1:18

NANCY HAVILAND  
REGISTER OF DEEDS  
LIVINGSTON COUNTY, MI.  
48843

LSC952M

Register of Deeds Stamp & File Number

Public Land Survey.

T 2N R 5E

C-11

Property Controlling  
in Section

S      T      R       
S      T      R     

Miscellaneous  
Property in Sec.

S      T      R       
S      T      R     

Lot No.           , Recorded Plat             
Private Claims           

Bryan L. Boss, in a field survey on Oct. 5, 1998,  
to hereby certify that under requirements of P.A. 74, Michigan P.A. of 1970, the corner points mentioned  
in lines 1 and 2 above were in conformance with regulations and rules therefore as required in the  
current manual of survey instructions of the United States Department of the Interior, Bureau of Land  
Management or by a decree of a Court of Law and/or that the corner points mentioned in lines 3, 4 and 5  
above were in conformance with the rules of the Michigan Board of Land Surveyors or by a Decree of a  
Court of Law; established, re-established, monumented, re-monumented, recovered, found as  
expressed below:

NOTE: Not more than 4 corners, all in the same town and range, may be recorded  
on this certificate.

1. Description of original monument and accessories and/or subsequent restoration:

Corner set by S. Sibley, County Surveyor, set post  
30" White Oak S 10½ W 47 links  
10" White Oak S 76½ W 71 links

2. Description of corner evidence found and/or method applied in restoring or reestablishing corner:


Found T iron in Centerline  
Brighton road  
occupation North and South are  
old fence lines.

P.A. 345 1990, APPROVED BY LIVINGSTON COUNTY

PEER GROUP ON 9-2-98 CO. REP JED

3. Description of monument for corner and accessories established to perpetuate locating the position of the corner:

Set 30" long by 1½" steel pipe with a 6" long breakaway top  
with Brass cap stamped "Livingston County Monumentation Corner"  
N 80 E 84.83 set Remon N/T Southside of 24" Walnut  
S 40 W 23.19 set Remon N/T Northeast side of 36" Walnut  
S 40 W 27.89 set Remon N/T Northwest side 12" Hickory  
N 40 W 33.94 set Remon N/T Southwest side 22" Walnut

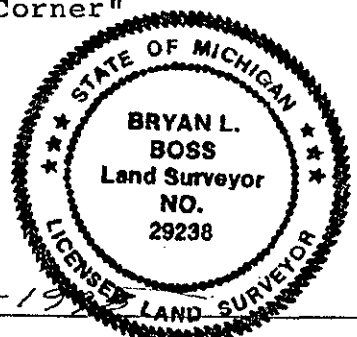

Signed by Bryan L. Boss

Date 10-15-1998

Surveyor's Michigan License No. 29238