

SURVEY & REMONUMENTATION

FEB 24 1998

SECTION

LAND CORNER RECORDATION CERTIFICATE
Filing Requirement of Act 74, Mich. P.A. 1970

FILED

For corners in

LIVINGSTON
(County)

Located In:
GENOA TWP.

Corner Code =/

1. Public Land Survey

T 2N R 5E

C-13

2. Property Controlling
in Section

S T R

3. Miscellaneous
Property in Sec.

S T R

1997 NOV 25 A 11:12

NANCY HAVILAND
REGISTER OF DEEDS
LIVINGSTON COUNTY, MI.
48843

L.S.C. #818m
Register of Deeds Stamp & File Number

4. Lot No. , Recorded Plat
5. Private Claims

	A	B	C	D	E	F	G	H	I	J	K	L	M
2	6		5		4		3		2		1		
3													
4	7		8		9		10		11		12		
5													
6	18		17		16		15		14		13		
7													
8	19		20		21		22		23		24		
9													
10	30		29		28		27		26		25		
11													
12	31		32		33		34		35		36		
13													

BRYAN L. BOSS, in a field survey on SEPTEMBER 21, 1997
do hereby certify that under requirements of P.A. 74, Michigan P.A. of 1970, the corner points mentioned
in lines 1 and 2 above were in conformance with regulations and rules therefore as required in the
current manual of survey instructions of the United States Department of the Interior, Bureau of Land
Management or by a decree of a Court of Law and/or that the corner points mentioned in lines 3, 4 and 5
above were in conformance with the rules of the Michigan Board of Land Surveyors or by a Decree of a
Court of Law; established, re-established, monumented, re-monumented, recovered, found as
expressed below:

NOTE: Not more than 4 corners, all in the same town and range, may be recorded
on this certificate.

Description of original monument and accessories and/or subsequent-restoration:


BLACK OAK 16" N 44 W 10 LINKS
WHITE OAK 10" N 83 E 78 LINKS

Description of corner evidence found and/or method applied in restoring or reestablishing corner:

FOUND 3/4" PIPE WITH CHARLES E. GARLOCK CAP #14762. THIS CORNER
IS 18 FEET± NORTH OF CENTERLINE OF SCHAFER ROAD.

Description of monument for corner and accessories established to perpetuate locating the position of the corner:

SET 1 1/4" X 36" IRON PIPE WITH BRASS CAP STAMPED
"LIVINGSTON COUNTY MONUMENTATION CORNER".
N 05 E 11.51' NAIL & TAG EAST SIDE 18" COTTONWOOD
EAST 28.60' NAIL & TAG SOUTH SIDE 16" OAK
S 45 E 55.16' NAIL & TAG EAST SIDE 16" OAK
S 45 W 61.07' NAIL & TAG EAST SIDE 6" POPLAR

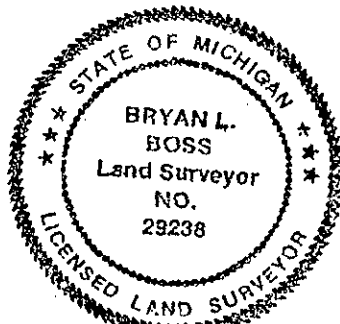

ned by

Date Sept. 25, 1997

veyor's Michigan License No. 29238

FORM APPROVED BY MICHIGAN STATE BOARD OF LAND SURVEYORS, JAN. 28, 1971
REVISED MAY 14, 1975
REVISED JAN., 1983

P.A. 345 1980, APPROVED BY LIVINGSTON COUNTY
PEER GROUP ON 6-18-97 CO. REP JEO

**SUMMARY
C-13**

Southeast Corner, Section 31, Genoa Township.

Town line surveyed December 15th by Alex Holmes. Lyle Munsell surveyed on 10-3-61 records S.E. Corner, Section 31 is 18 feet North of Centerlin Schaffer Road. On 4-29-66, Atwell- Hicks found spike and replaced with a 3/4" X 18" iron pipe.

Witnesses:


Lyle Munsell's August 1961 witnesses no. 2-5-6 were found by Benton on 9-25-74 and also found by Glenn Richard on 3-8-83, Charles Garlock also found witnesses in April 1985, and again on September 19, 1990 Garlock found two witnesses remaining and they checked. Boss found 2-6 on May 2, 1997 and they checked.

Distances:

Atwell-Hicks and Patrick Benton recorded 2663.80 / 2663.38 feet westerly. Charles Garlock and David Finney recorded 2638.95 feet Easterly. Boss measured 2638.90.

This corner is 18 feet \pm North of the centerline of Schaffer Road and will be a difficult G.P.S.

We find the preponderance of evidence describes the 3/4" iron pipe with cap #14762 (Charles Garlock) as found to be the Southeast Corner, Section 31, and recommended acceptance.

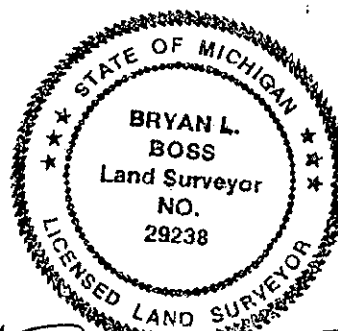

File: Sumc-13

Bryan L. Boss