

FEB 25 1999

SECTION

LAND CORNER RECORDATION CERTIFICATE
Filing Requirement of Act 74, Mich. P.A. 1970

FILED

For corners in

Livingston
(County)

Located in:

Corner Code 11

1998 OCT 22 P 1:18

NANCY HAVILAND
REGISTER OF DEEDS
LIVINGSTON COUNTY, MI.
48843

LSC954M

Register of Deeds Stamp & File Number

1. Public Land Survey 1 2N R 5E D-11
T R
T R
T R
2. Property Controlling S T R
in Section S T R
3. Miscellaneous S T R
Property in Sec. S T R

4. Lot No. _____, Recorded Plat _____
5. Private Claims _____

I, Bryan L. BOSS, in a field survey on October 5, 1998, do hereby certify that under requirements of P.A. 74, Michigan P.A. of 1970, the corner points mentioned in lines 1 and 2 above were in conformance with regulations and rules therefore as required in the current manual of survey instructions of the United States Department of the Interior, Bureau of Land Management or by a decree of a Court of Law and/or that the corner points mentioned in lines 3, 4 and 5 above were in conformance with the rules of the Michigan Board of Land Surveyors or by a Decree of a Court of Law; established, re-established, monumented, re-monumented, recovered, found as expressed below:

NOTE: Not more than 4 corners, all in the same town and range, may be recorded on this certificate.

A. Description of original monument and accessories and/or subsequent restoration:

Corner Set in 1823 by S. Sibley, Deputy Surveyor, Set Post

14" White Oak S. 38W 7 links
14" Black Oak N. 2E 71 links

B. Description of corner evidence found and/or method applied in restoring or reestablishing corner:


FD, 1/2" I Rod 2.5 Deep
3' North of Centerline Brighton Rd. and
2' West of Centerline Richardson Rd.

P.A. 345 1980, APPROVED BY LIVINGSTON COUNTY

PEER GROUP ON 9-2-98 CO. REP LED

C. Description of monument for corner and accessories established to perpetuate locating the position of the corner:

Set 30' long by 1 1/4" Steel Pipe
with a 6" long by 1 1/4" Steel Break away top W/Brass Cap Stamped
"Livingston County Monumentation Corner"
29238 (1' Deep)
N 60 E 73.86 Remon N/T S.E. Side 7" Oak
S 60 E 77.34 Remon N/T S. Side 18" Oak
S 60 W 50.45 Remon N/T N.W. side 18" Oak
N 30 W 72.02 Remon N/T N.E. side 10" Hickory

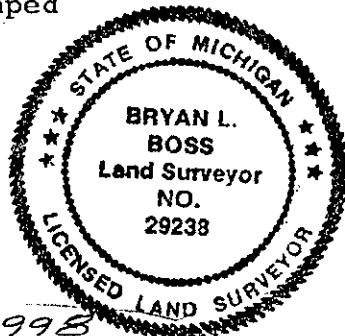

Signed by Bryan L. Boss
Surveyor's Michigan License No. 29238

Date 10-14-1998