

FEB 24 1998

SECTION

LAND CORNER RECORDATION CERTIFICATE

Filing Requirement of Act 74, Mich. P.A. 1970

FILED

For corners in

LIVINGSTON Located In: GENOA TWP. Corner Code ==

1. Public Land Survey T 2N R 5E D-13

2. Property Controlling S T R

3. Miscellaneous S T R

4. Lot No. , Recorded Plat

5. Private Claims

1997 NOV 25 A 11:13

NANCY HAVILAND
REGISTER OF DEEDS
LIVINGSTON COUNTY, MI.
48843

L. S. C. #819m

Register of Deeds Stamp & File Number

I, BRYAN L. BOSS, in a field survey on SEPTEMBER 21, 1997, do hereby certify that under requirements of P.A. 74, Michigan P.A. of 1970, the corner points mentioned in lines 1 and 2 above were in conformance with regulations and rules therefore as required in the current manual of survey instructions of the United States Department of the Interior, Bureau of Land Management or by a decree of a Court of Law and/or that the corner points mentioned in lines 3, 4 and 5 above were in conformance with the rules of the Michigan Board of Land Surveyors or by a Decree of a Court of Law; established, re-established, monumented, re-monumented, recovered, found as expressed below:

NOTE: Not more than 4 corners, all in the same town and range, may be recorded on this certificate.

A. Description of original monument and accessories and/or subsequent restoration:


WHITE OAK 9" N 14 W 11 LINKS
WHITE OAK 12" S 15 W 10 LINKS
WHITE OAK 14" N 34 E 0.78 CHAINS

B. Description of corner evidence found and/or method applied in restoring or reestablishing corner:

FOUND 1/2" INCH IRON ROD ONE FOOT± BELOW THE GRAVEL SURFACE.
CHECKED 34.55 FEET EAST OF THE NORTH 1/4 CORNER, SECTION 5, HAMBURG TOWNSHIP. CORNER IS IN CENTER OF SCHAFER ROAD.

C. Description of monument for corner and accessories established to perpetuate locating the position of the corner:

SET 1 1/4" X 30" IRON PIPE WITH 6" INCH BREAK OFF AND BRASS CAP STAMPED "LIVINGSTON COUNTY MONUMENTATION CORNER".
S 70 W 74.61' NAIL & TAG SOUTH SIDE 6" MULBERRY
N 70 W 72.67' NAIL & TAG SOUTH SIDE 8" MULBERRY
N 15 E 101.81' NAIL & TAG EAST SIDE 24" OAK
SOUTH 71.45' NAIL & TAG WEST SIDE 6" BOX ELDER

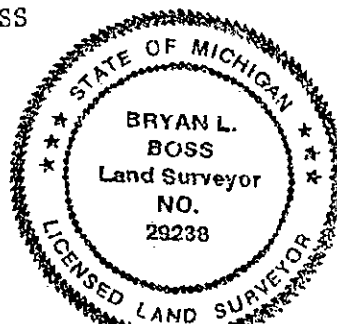

Signed by Bryan L. Boss Date Sept. 23, 1997
Surveyor's Michigan License No. 29238

P.A. 345 1980, APPROVED BY LIVINGSTON COUNTY
PEER GROUP ON 8-20-97 CO. REP JED

SUMMARY

D-13

South 1/4 Corner, Section 32, Genoa Township.

This corner was set in December of 1815 by Alex Holmes.


On December 3, 1969, Oscar Boss surveyed the West 1/2 of the Northeast 1/4 section 5, Hamburg Township but does not record jog. On March 12, 1976, Munsell & Garlock split parcels in the West 1/2 of the Southeast 1/4, Section 32, Genoa Township. This survey and Act 74 which were recorded in November 1976, logs witnesses. One witness was found and used by Boss Engineering and Finney & Associates.

On February 27, 1980, Patrick L. Benton recorded Certificate of Survey and noted 34.63 feet jog at the 1/4 Corner. G.L.O. Map Records 30.5 feet.

In 1990, Charles Garlock & David Finney record witnesses and found jog measured 34.5 feet.

On 7-31-97, Boss Engineering found and checked Desine witnesses which were set on 3-8-96. The 1/2" Inch Iron rod 1 foot \pm below the gravel surface also checked 34.55 feet East of the North 1/4 corner, Section 5, Hamburg Township.

We find the 1/2" Iron found to be the same monument as recorded on Charles Garlock November 11, 1976 Act 74 and recommend it's acceptance as found. This corner is in center of Road and open for G.P.S., see pages 22 & 23 this dossier.

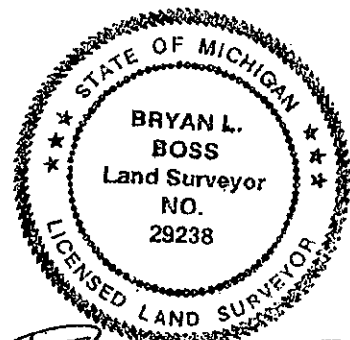

Bryan L. Boss