

DEC 29 11 24 AM '93

## LAND CORNER RECORDATION CERTIFICATE

Filing Requirement of Act 74, Mich. P.A. 1970  
 NANCY HAVILAND  
 REGISTER OF DEEDS  
 LIVINGSTON COUNTY, MI  
 48843

For corners in

Livingston Located In: Corner Code ##

1. Public Land Survey T 2N R 5E J-11  
 T      R            
 T      R            
 T      R
2. Property Controlling S      T      R       
 in Section S      T      R
3. Miscellaneous S      T      R       
 Property in Sec. S      T      R

L.S.C. #166m

Register of Deeds Stamp &amp; File Number

4. Lot No.           , Recorded Plat
5. Private Claims

I, Bryan Ross, in a field survey on December 22, 19 93,  
 do hereby certify that under requirements of P.A. 74, Michigan P.A. of 1970, the corner points mentioned  
 in lines 1 and 2 above were in conformance with regulations and rules therefore as required in the  
 current manual of survey instructions of the United States Department of the Interior, Bureau of Land  
 Management or by a decree of a Court of Law and/or that the corner points mentioned in lines 3, 4 and 5  
 above were in conformance with the rules of the Michigan Board of Land Surveyors or by a Decree of a  
 Court of Law; established, re-established, monumented, re-monumented, recovered, found as  
 expressed below:

NOTE: Not more than 4 corners, all in the same town and range, may be recorded  
 on this certificate.

## A. Description of original monument and accessories and/or subsequent restoration:

W. Oak 10 in. Dia. S6 1/2E 25 Lks  
 B. Oak 14 in. Dia. N57W 17 Lks

Nail in Concrete 1971 Found by Garlock

SURVEY &  
 RE-MONUMENTATION

1993

COMMISSION

## B. Description of corner evidence found and/or method applied in restoring or reestablishing corner:

Found 1/2" Iron Rod in Monument Box Centerline Brighton Road


## C. Description of monument for corner and accessories established to perpetuate locating the position of the corner:

Set Brass Cap Marked: Livingston  
 Co. Monument Corner Over 1/2" x 30"  
 Iron Rod in Monument Box

S44°E 35.58' Spike 8" Ash  
 S6°W 26.04' Spike Power Pole  
 N68°W 63.84' Spike 30" Oak

Approved by Livingston Co.  
 Monumentation Peer Group  
 on December 1, 1993

Signed by Bryan Ross  
 Surveyor's Michigan License No. 29238

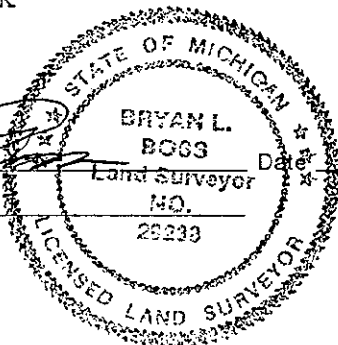

December 28, 1993

# **BOSS ENGINEERING**

## **ENGINEERS & SURVEYORS**

December 1, 1993

### SUMMARY

J-11                      North 1/4 Corner, Section 35, Genoa Township,  
T2N-R5E, Livingston County, Michigan


In 1971, distance of 1320.73 O. A. measured by Garlock Westerly from Conc. Nail at 1/4 Corner, page 4 - Munsell & Garlock - 1-14-72 show witnesses that coincide with Oscar Boss LSC #327 dated 8-23-72.

Witness points from 1972 till 10-20-86 indicate nail in concrete.

Witnesses page 18 dated 10-1-90 are the same as page 17 dated 10-20-86 but during this time period, a monument box with 1/2" iron was installed by other.

Considering all witnesses on previous surveys, paper trail indicates found nail in concrete to be 1/2" iron in monument box.

File: REMON2

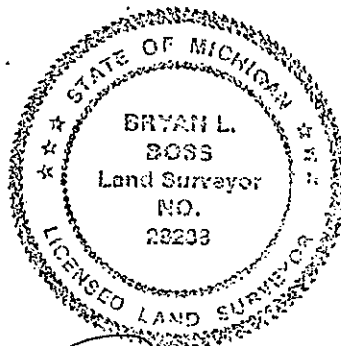

A handwritten signature in cursive script, appearing to read "Bryan L. Boss", written below the professional seal.

①