

SURVEY & REMONUMENTATION

MAR 17 2000

FILED

SECTION

LAND CORNER RECORDATION CERTIFICATE

Filing Requirement of Act 74, Mich. P.A. 1970

1999 NOV 22 A 11: 07

For corners in

LIVINGSTON

(County)

Located in: GENOA

Corner Code #

9

NANCY HAVILAND
REGISTER OF DEEDS
LIVINGSTON COUNTY, MI.
48843

1. Public Land Survey T 2N R 5E H-9
T R
T R
T R
2. Property Containing S T R
In Section S T R
3. Miscellaneous S 22 T 2N R 5E 004 ✓
Property in Section S 22 T 2N R 5E 005

LSC#1106m

Register of Deeds Stamp and File Number

4. Lot No. , Recorded Plat
5. Private Claims

I, Bryan L. Boss, in a field survey on NOV. 9, 1999

do hereby certify that under requirements of P.A. 74, Michigan P.A. of 1970, the corner points mentioned in lines 1 and 2 above were in conformance with regulations and rules therefor as required in the current manual of survey instructions of the United States Department of the Interior, Bureau of Land Management or by a decree of a Court of Law and/or that the corner points mentioned in lines 3, 4 and 5 above were in conformance with the rules of the Michigan Board of Land Surveyors or by a Decree of a Court of Law; established, re-established, monumented, re-monumented, recovered, found as expressed below.

NOTE: Not more than 4 corners, all in the same town and range, may be recorded on this certificate.

A. Description of original monument and accessories and/or subsequent restoration:

1/4 SECTION CORNER IN LAKE
NO POST OR MARKINGS

B. Description of corner evidence found and/or method applied in restoring or reestablishing corner:

CORNER POSITION ESTABLISHED ON STRAIGHT LINE BETWEEN CORNERS G-9 AND I-9 AT THE INTERSECTION OF THE N-S 1/4 LINE. AS IDENTIFIED BY TWO MONUMENTS IN CONRAD'S SUBDIVISION, L.3, PG. 46 L.C.

REFERENCE POINT 1 IS A CONCRETE MONUMENT WITH A BRASS CAP STAMPED "MICHIGAN CONSERVATION DEPARTMENT" "PUBLIC FISHING SITE" ON EAST SIDE OF CROOKED LAKE NEAR LINE BETWEEN SECTION 22 & 27

THE CORNER POSITION IS PERPETUATED WITH TWO REFERENCE POINTS.

H-9 TO REF. PT. 1 N 86° 39' 21" E, 705.72'
H-9 TO REF. PT. 2 S 02° 24' 49" E, 732.08'
REF. PT. 1 TO 2, S 41° 05' 16" W, 1025.07'

REFERENCE POINT 2 IS A SET 1 1/4" X 36" PIPE W/BRASS CAP ON THE EAST LINE OF "CONRAD'S SUB" AND ON THE SOUTH LINE OF SKUSA DRIVE REPLACING THE PIPE FOUND AT THE NE CORNER LOT 38


C. Description of monument for corner and accessories established to perpetuate locating the position of the corner:

REFERENCE POINT 1 - 004
FOUND CROSS IN BRASS CAP STAMPED
"MICHIGAN CONSERVATION DEPARTMENT"
"FISHING SITE" IN A 4" CONCRETE MONUMENT
N5°W 17.42' SET REMON N/TAG E/S 12" POPLAR
EAST 3.40' SET REMON NAIL/TAG N/S 6" R. OAK
S10°W 25.73' SET REMON N/TAG E/S 16" BOX
ELDER
S85°W 9.96' SET REMON NAIL/TAG N/S 9" CHERRY

REFERENCE POINT 2 - 005
SET 1 1/4" X 36" PIPE WITH BRASS CAP STAMPED
LIVINGSTON COUNTY REMONUMENTATION
WITNESS
SOUTH 3.85' SET REMON NAIL/TAG E/S P. POLE
EAST 27.78' SET REMON NAIL/TAG N/S 12" OAK
N10°E 17.94' SET REMON NAIL/TAG E/S P. POLE
N80°W 121.30' SET REMON NAIL/TAG S/S P. POLE

PA. 345 380, APPROVED BY LIVINGSTON COUNTY

PEER GROUP ON 9-15-99 CO. REP JED

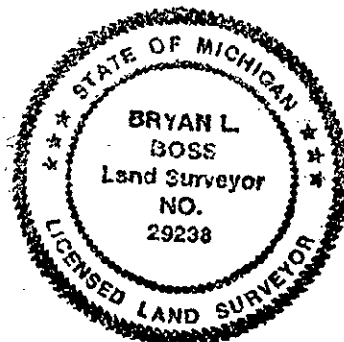

Signed by Bryan L. Boss

Date NOV. 11, 1999

Surveyor's Michigan License No. 29238