

SURVEY &
REMONUMENTATION

FEB 25 1999

9-
FILED

SECTION

LAND CORNER RECORDATION CERTIFICATE

Filing Requirement of Act 74, Mich. P.A. 1970 1998 OCT 27 P 2:23

or corners in
Livingston

(County)

Located In:

Corner Code //

NANCY HAVILAND
REGISTER OF DEEDS
LIVINGSTON COUNTY, MI.
48843

Public Land Survey.

T 2N R 6E

G-3

T _____ R _____

T _____ R _____

T _____ R _____

Property Controlling
in Section

S _____ T _____ R _____

S _____ T _____ R _____

Miscellaneous
Property in Sec.

S _____ T _____ R _____

S _____ T _____ R _____

LSC976M

Register of Deeds Stamp & File Number

Lot No. _____, Recorded Plat _____
Private Claims _____

Bryan L. Boss, in a field survey on Oct. 7, 1998,
do hereby certify that under requirements of P.A. 74, Michigan P.A. of 1970, the corner points mentioned
in lines 1 and 2 above were in conformance with regulations and rules therefore as required in the
current manual of survey instructions of the United States Department of the Interior, Bureau of Land
Management or by a decree of a Court of Law and/or that the corner points mentioned in lines 3, 4 and 5
above were in conformance with the rules of the Michigan Board of Land Surveyors or by a Decree of a
Court of Law; established, re-established, monumented, re-monumented, recovered, found as
expressed below:

NOTE: Not more than 4 corners, all in the same town and range, may be recorded
on this certificate.

Description of original monument and accessories and/or subsequent restoration:

Set post corner to Sec. 3,4,9,10

	A	B	C	D	E	F	G	H	I	J	K	L	M
2	6	5	4	3	2	1							
3													
4	7	8	9	10	11	12							
5													
6	16	17	18	19	20	21							
7													
8	19	20	21	22	23	24							
9													
10	30	29	28	27	26	25							
11													
12	31	32	33	34	35	36							
13													

Description of corner evidence found and/or method applied in restoring or reestablishing corner:

Found capped iron (#19005)

PA. 345 1990, APPROVED BY LIVINGSTON COUNTY
PEER GROUP ON 8-19-98, CO. REP JED

Description of monument for corner and accessories established to perpetuate locating the position of the corner:

Set 30" by 1½" pipe with 6" breakaway and Brass cap stamped
"Livingston County Remonumentation"


S 5 E 109.14 set Remon N/T Westside 20" Oak

N 80 E 165.59 set Remon N/T Southside 24" Oak

North 27.38 set Remon N/T Eastside 12" Cherry

S 75 W 20.54 set Remon N/T Southeast side Dead 16" Oak

S 20 W 45.83 set Remon N/T Southeast 20" Maple

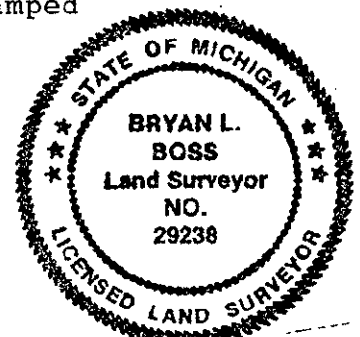

Signed by Bryan L. Boss

Date 10-16-1998

Surveyor's Michigan License No. 29238